


T. 24 S., R. 7 W., W.M., Section 17

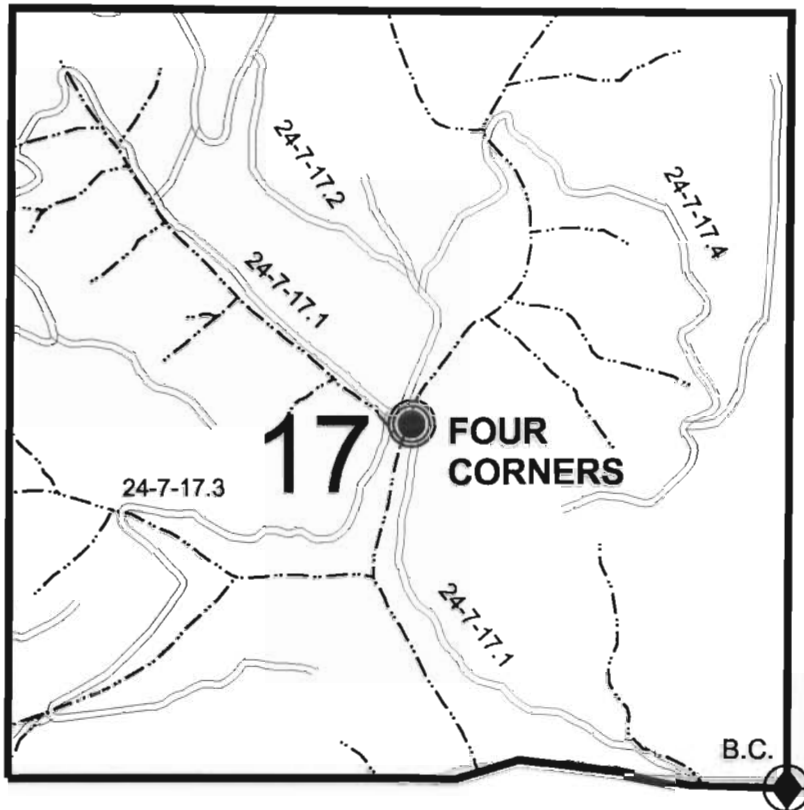

Diversion is:
2512 ft. North and
2565 ft. West of the
SE cor. Sec 17

CLAIM OF BENEFICIAL USE MAP

in name of

UNITED STATES BUREAU OF LAND MANAGEMENT

RECEIVED

SEP 25 2000


WATER RESOURCES DEPT.
SALEM, OREGON

Application No.: R - 71505

S - 71506

Permit No.: R - 12047

52823

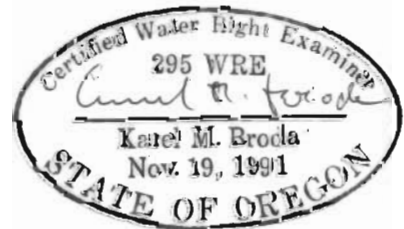

Expires: 12/31/01

SURVEYED: May 6, 2000

THIS MAP WAS PREPARED FOR THE PURPOSE OF IDENTIFYING THE LOCATION OF A WATER RIGHT ONLY
AND IS NOT INTENDED TO PROVIDE LEGAL DIMENSIONS OR LOCATION OF PROPERTY OWNERSHIP LINES.

U.S. Bureau of Land Management
Roseburg District Office
Division of Operations

Executed by:
Karel M. Broda, PE, CWRE
777 N.W. Garden Valley Blvd.
Roseburg, Oregon 97470