


T. 26 S., R. 7 W., W.M., Section 5

Diversion is:
3 ft. South and
1148 ft. West of the
N 1/4 cor. Sec 5

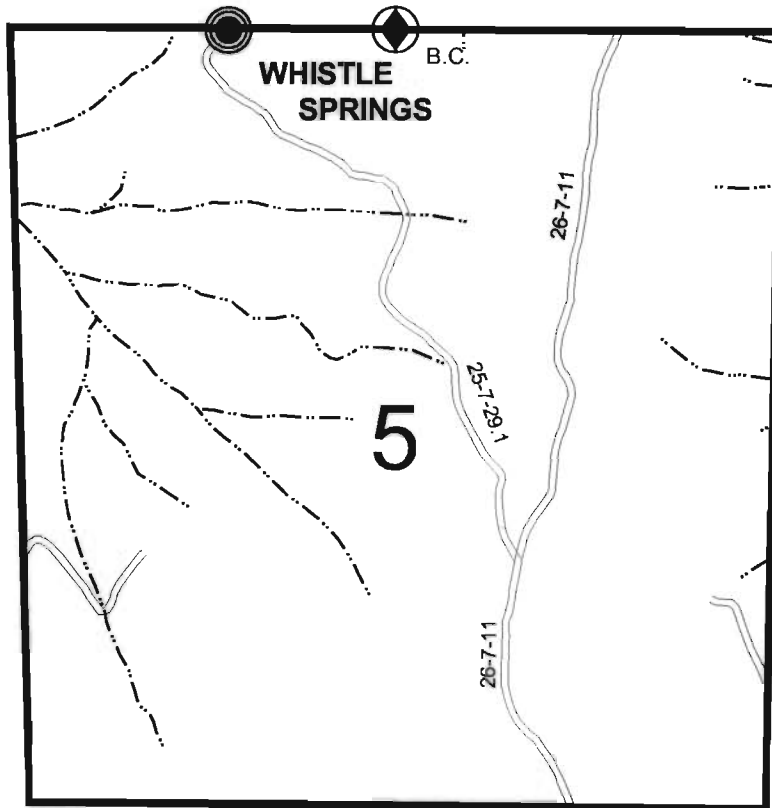

SCALE:
1" = 1320'



CLAIM OF BENEFICIAL USE MAP

in name of

UNITED STATES BUREAU OF LAND MANAGEMENT

Application No.: R - 71503

S - 71504

Permit No.: R - 12118

53015

RECEIVED

SEP 25 2000

WATER RESOURCES DEPT.
SALEM, OREGON



SURVEYED: June 6, 2000

Expires: 12/31/01

THIS MAP WAS PREPARED FOR THE PURPOSE OF IDENTIFYING THE LOCATION OF A WATER RIGHT ONLY
AND IS NOT INTENDED TO PROVIDE LEGAL DIMENSIONS OR LOCATION OF PROPERTY OWNERSHIP LINES.

U.S. Bureau of Land Management
Roseburg District Office
Division of Operations

Executed by:
Karel M. Broda, PE, CWRE
777 N.W. Garden Valley Blvd.
Roseburg, Oregon 97470

FINAL PROOF MAP


RECEIVED

NOV 20 1988

WATER RESOURCES DEPT.
SALEM, OREGON



Scale 1" = 1000'

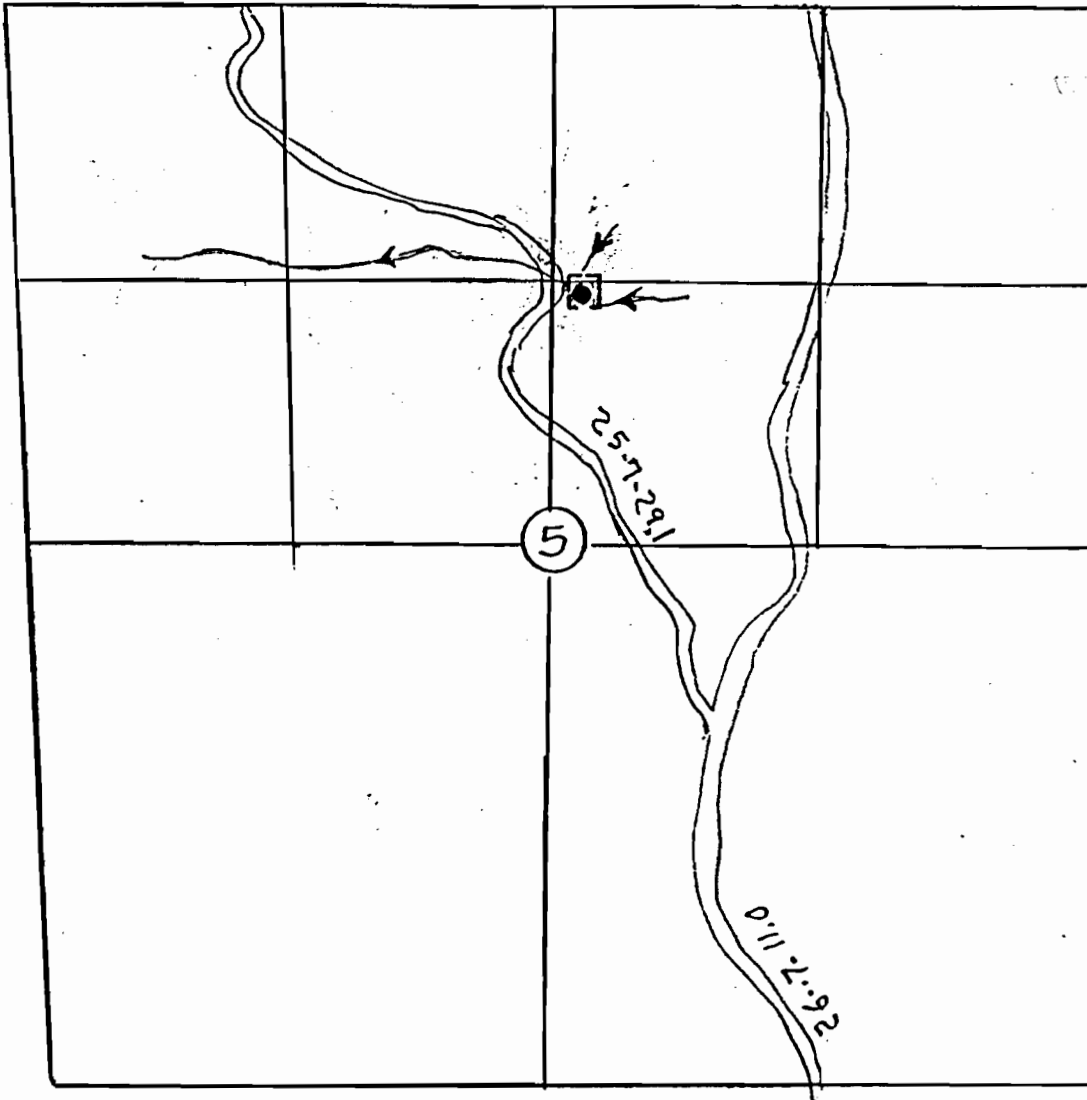


WHISTLE SPRINGS POND
T26S R7W Sec 5
SW $\frac{1}{4}$, NE $\frac{1}{4}$

The point of diversion is located 1400 ft South and 2550 ft West from the Northeast Section Corner of Section 5.

Coordinate Ties are based on aerial photo 6-4-89.

The map is shown for the purpose of water application and not property boundary.

Application No. 71504 / 71503
Permit No. R12118

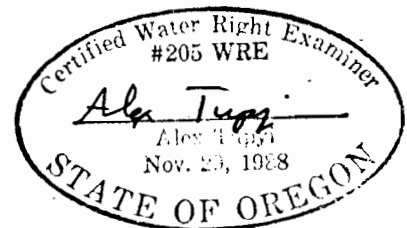

3-11-91