


# T. 24 S., R. 1 W., W.M., Section 35

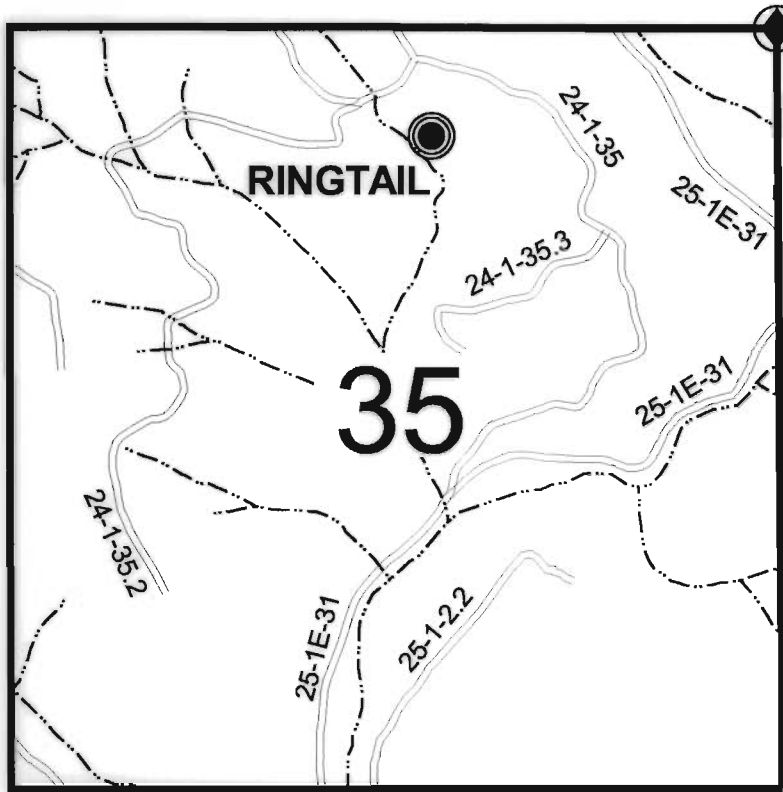

SCALE:  
1" = 1320'



**Diversion is:  
738 ft. South and  
2368 ft. West of the  
NE cor. Sec 35**

## CLAIM OF BENEFICIAL USE MAP

in name of

UNITED STATES BUREAU OF LAND MANAGEMENT

**Application No.: R - 71500  
S - 71499  
Permit No.: R - 12060  
52884**



Expires: 12/31/01

**RECEIVED**

SEP 25 2000

WATER RESOURCES DEPT.  
SALEM, OREGON

**SURVEYED: May 18, 2000**

THIS MAP WAS PREPARED FOR THE PUPOSE OF IDENTIFYING THE LOCATION OF A WATER RIGHT ONLY  
AND IS NOT INTENDED TO PROVIDE LEGAL DIMENSIONS OR LOCATION OF PROPERTY OWNERSHIP LINES.

U.S. Bureau of Land Management  
Roseburg District Office  
Division of Operations

Executed by:  
Karel M. Broda, PE, CWRE  
777 N.W. Garden Valley Blvd.  
Roseburg, Oregon 97470