


T. 26 S., R. 7 W., W. M.

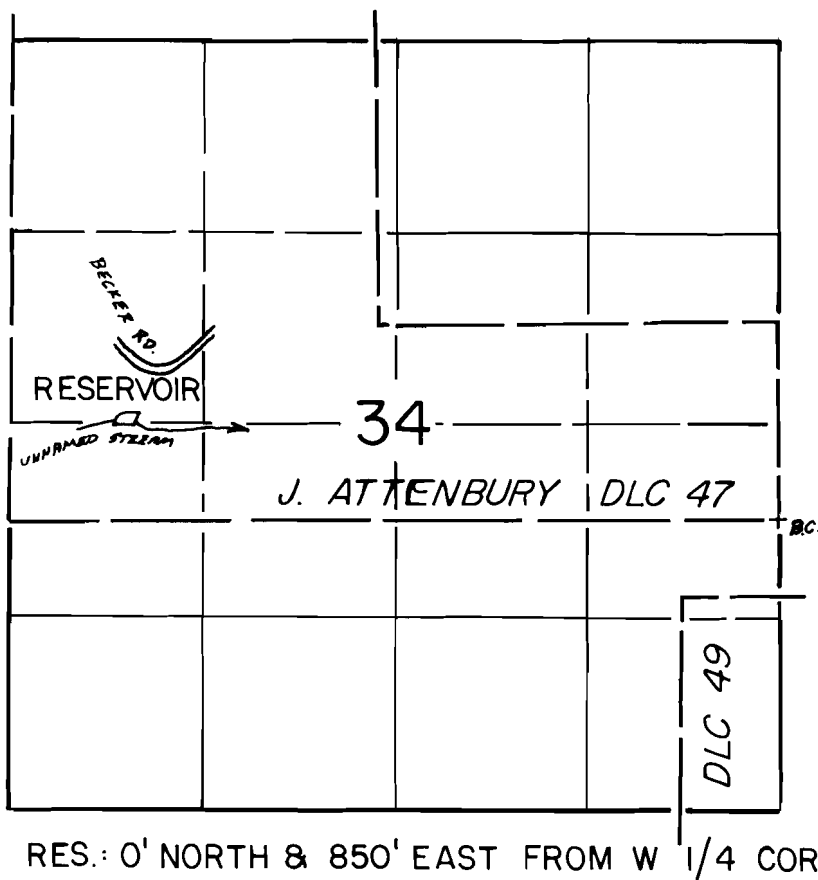

Scale : 1" = 1320'

FINAL PROOF SURVEY
UNDER

Application No. R-59838 Permit No. R-8287...
IN NAME OF

.....
Surveyed May 20, 1997., by B.S. DeHaas.....