


T. 25 S., R. 1 W., W.M., Section 3

Diversion is:
1975 ft. South and
1036 ft. East of the
NW cor. Sec 3

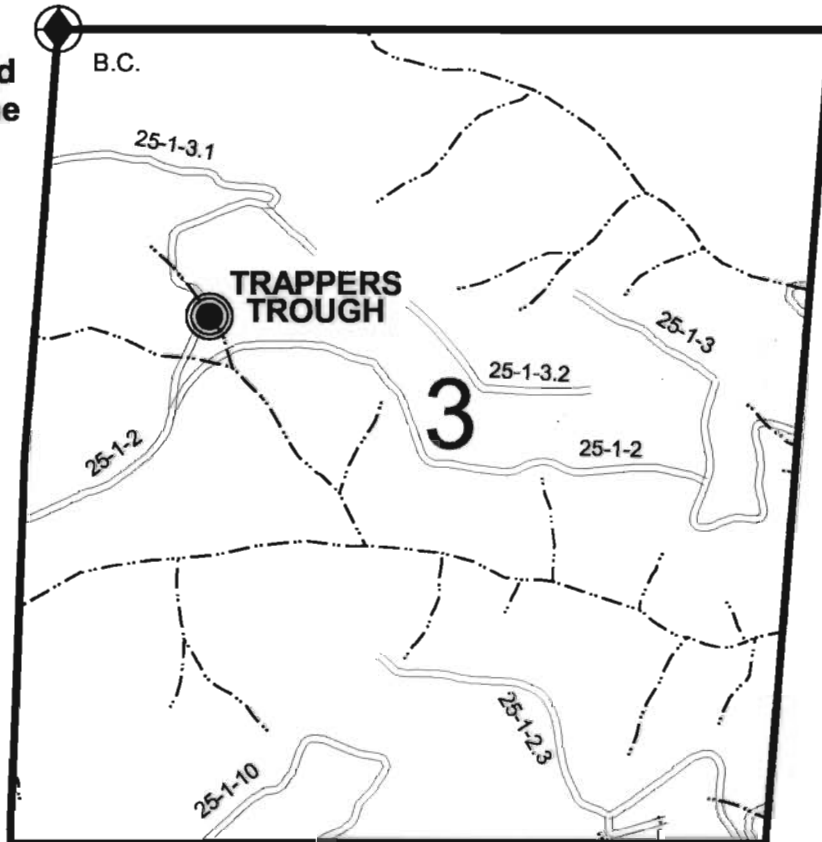

N
SCALE:
1" = 1320'

CLAIM OF BENEFICIAL USE MAP

in name of

UNITED STATES BUREAU OF LAND MANAGEMENT

Application No.: R - 71498

S - 71497

Permit No.: R - 11799

52286

RECEIVED

SEP 25 2000

WATER RESOURCES DEPT.
SALEM, OREGON



Expires: 12/31/01

SURVEYED: May 18, 2000

THIS MAP WAS PREPARED FOR THE PUPOSE OF IDENTIFYING THE LOCATION OF A WATER RIGHT ONLY
AND IS NOT INTENDED TO PROVIDE LEGAL DIMENSIONS OR LOCATION OF PROPERTY OWNERSHIP LINES.

U.S. Bureau of Land Management
Roseburg District Office
Division of Operations

Executed by:
Karel M. Broda, PE, CWRE
777 N.W. Garden Valley Blvd.
Roseburg, Oregon 97470

FINAL PROOF MAP


RECEIVED

APR 02 1991

WATER RESOURCES DEPT.
SALEM, OREGON



Scale 1" = 1000'

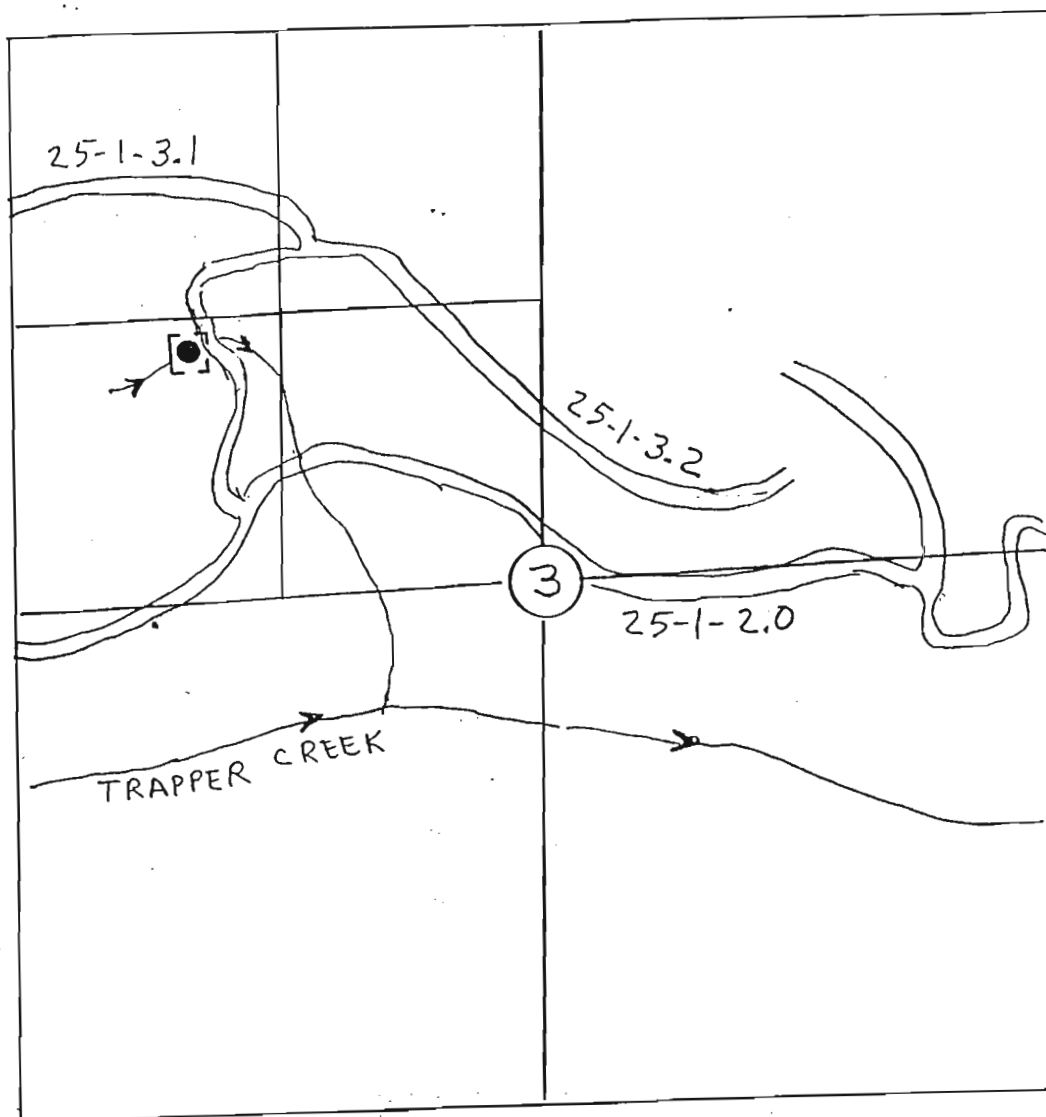


TRAPPER'S TROUGH
T25S R1W Sec 3
SW $\frac{1}{4}$, NW $\frac{1}{4}$

The point of diversion is located approximately 1700 ft South and 900 ft East from the Northwest Section Corner of Section 3.

Coordinate Ties are based on aerial photo 9-51-15.

The map is shown for the purpose of water application and not property boundary.

Application No. *R* 71497
Permit No. *R* 11799

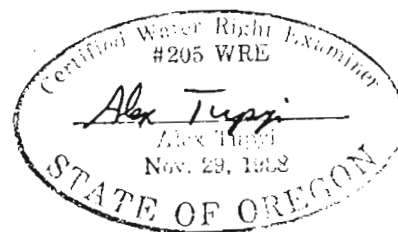

3-11-91