

SECTION 28, T.1S., R.3W., W.M.

WASHINGTON COUNTY, OREGON

1/4 COR.

20 21

29 28

MAP BASE:
ASSESSORS MAP
SCALED COLORED
PHOTO

PREPARATION OF THIS MAP IS FOR THE
PURPOSE OF IDENTIFYING THE LOCATION OF
THE WATER RIGHT ONLY. THERE IS NO INTENT
TO PROVIDE DIMENSIONS OR LOCATION OF
PROPERTY OWNERSHIP LINES.



SCALE: 1"=400'

GNOS ROAD

T.L. 300



2320'

2320'

930'

1675'

WEST 1/4 COR.

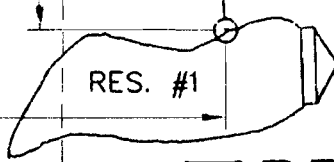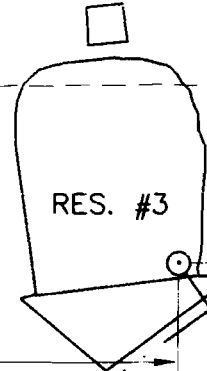

FINAL PROOF SURVEY

UNDER

APPLICATION

R-84041

PERMIT

R-12735

SURVEYED JUNE 25, 2004



VERBOORT ENGINEERING

AGRICULTURE · CML · WATER RESOURCES
HILLSBORO, OREGON

designed	WRV	06/04
drawn	JPR	06/04
checked	WRV	06/04
drawing no.	04-A-08	
sheet no.	1 / 1	

RON HOCHSTEIN

38100 S.W. GNOS RD.
CORNELIUS, OR 97113