

NOTE: THIS MAP IS THE LOCATION OF WATER RIGHTS AND IS NOT  
TO PROVIDE LEGAL DIMENSIONS OR LOCATION OF PROPERTY LINES.



REF-----

SEP 22 1995

T. 18 S., R. 5 W., W.M.

WATER RESOURCES DEPT.  
SALEM, OREGON

SCALE : 1"=1000'

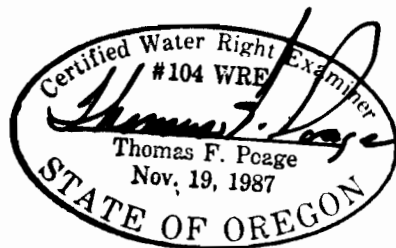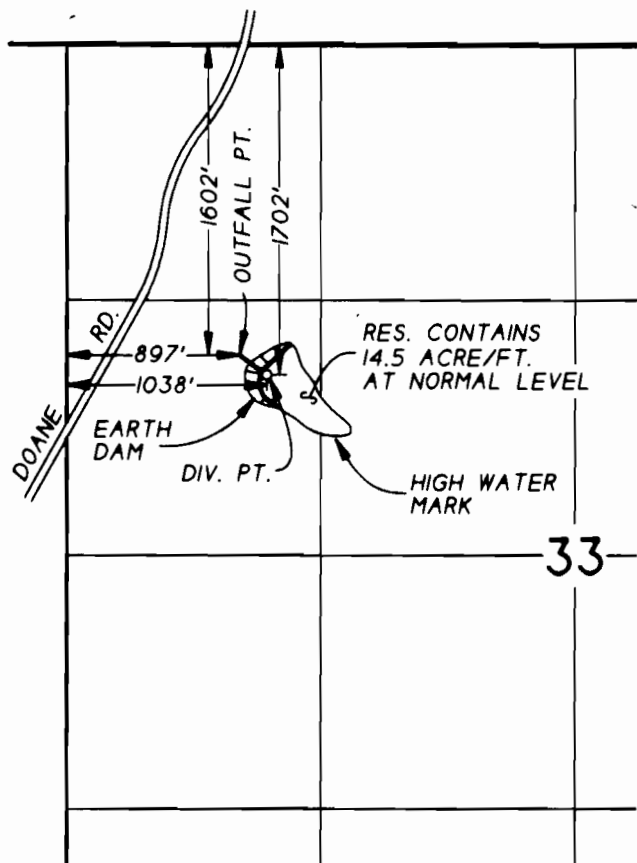

**FINAL PROOF SURVEY**  
UNDER

APPLICATION No. R-71488, PERMIT No. R-11403

IN NAME OF

**TRUTZ KRONKE**

SURVEYED SEPTEMBER 16, 1995, by POAGE ENG. & SURVEYING INC.