

SEC. 14 T. 7 S., R. 6 W., W.M.

POLK COUNTY, OREGON

SCALE: 1" = 400'

SEC CORNER
& NE DLC No. 44

11 | 12

14 | 13

1/4 COR = NLY NW
J. PANKEY DLC NO. 44

NOTE:
THIS MAP IS FOR THE
PURPOSE OF IDENTIFYING
WATER RIGHTS AND HAS
NO INTENT TO DIMENSION
OF LOCATE PROPERTY
OWNERSHIP LINES

NW 1/4 - NE 1/4

NE 1/4 - NE 1/4

T. LOT 101

SW 1/4 - NE 1/4

SE 1/4 - NE 1/4

DIV.
POINT

2270'

RECEIVED

JUL 27 1995

WATER RESOURCES DEPT.
SALEM, OREGON

RE-ENT
CORNER
DLC No. 44



C 1/4 CORNER

FINAL PROOF MAP

1/4 CORNER

UNDER
R-71370

R-11421


APPLICATION NO. _____

PERMIT NO. _____

IN NAME OF:

BETTIE L. DUHRKOPF
DON DUHRKOPF

1995 REUBEN BOISE RD.
DALLAS, OR 97338
PH. 623-6710

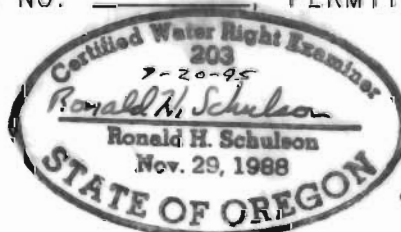

Lic. Reg.
6-30-96

PREPARED BY:
J & R SURVEYORS
P. O. BOX 418
DALLAS OR. 97338
Ph (503) 6234-4003

95-31-W3

SURVEYED JUNE, 1995 BY: R. SCHULSON