


# T. 10S., R. 39 & 40E., W.M.

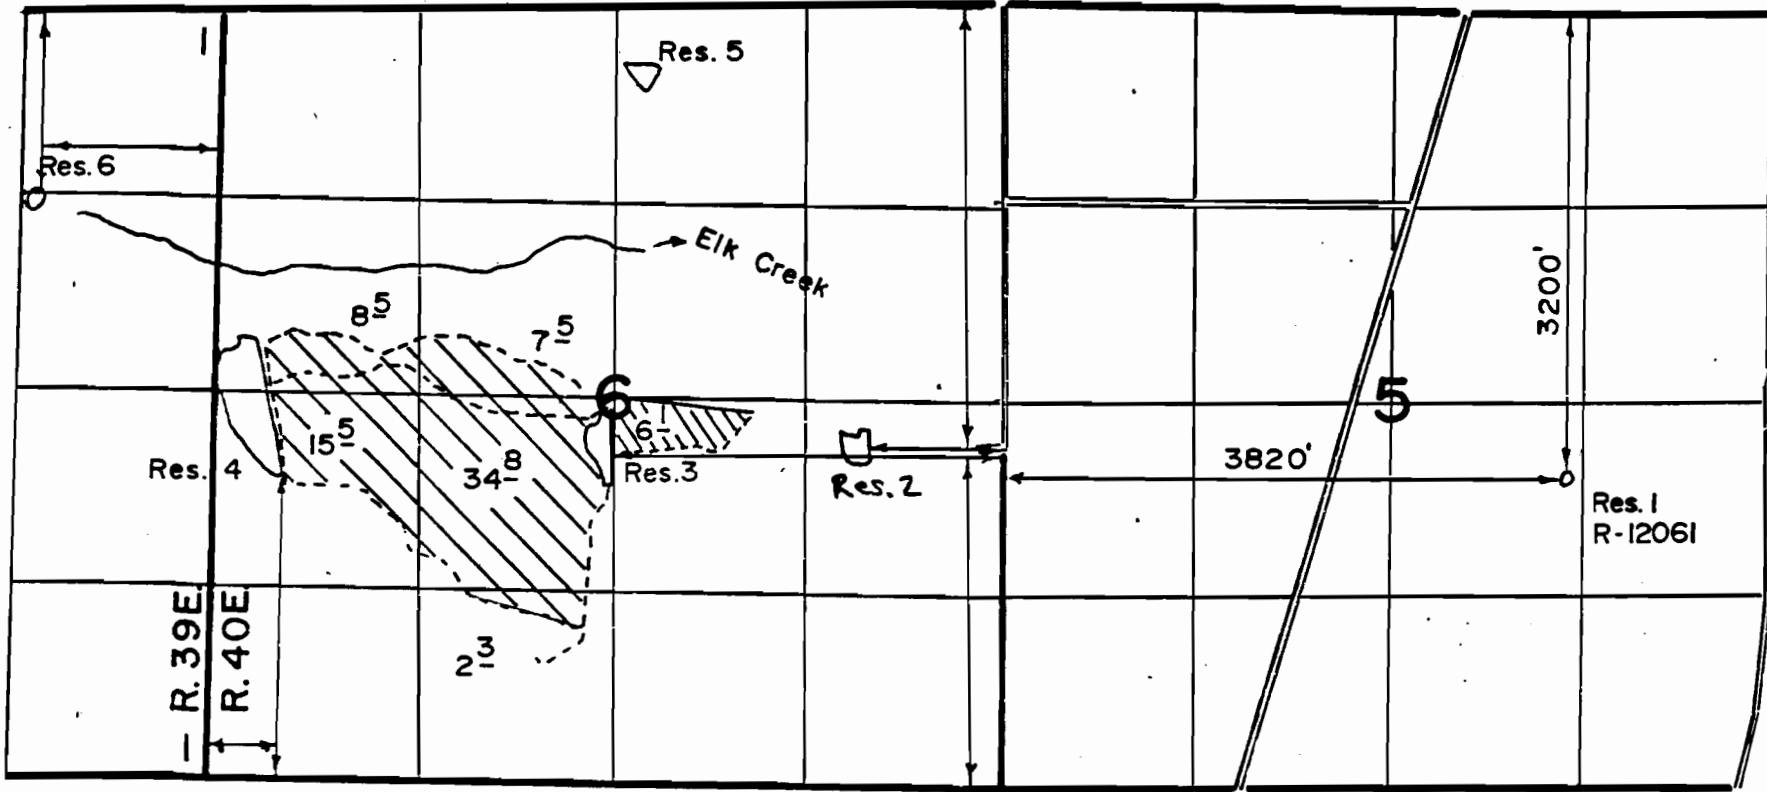

The purpose of this map is for identifying the location of the water right only and is not intended to provide legal dimensions of property ownership lines.

## FINAL PROOF SURVEY

APPL. R-71441  
R-71442  
71443

PER. R-12061  
R-11864  
52438

-  Res 3 & 4
-  Res 4

IN NAME OF  
FOSTER RANCH

SURVEYED SEPT. 25, 2000

**RECEIVED**

OCT 02 2000

WATER RESOURCES DEPT  
SALEM, OREGON

