



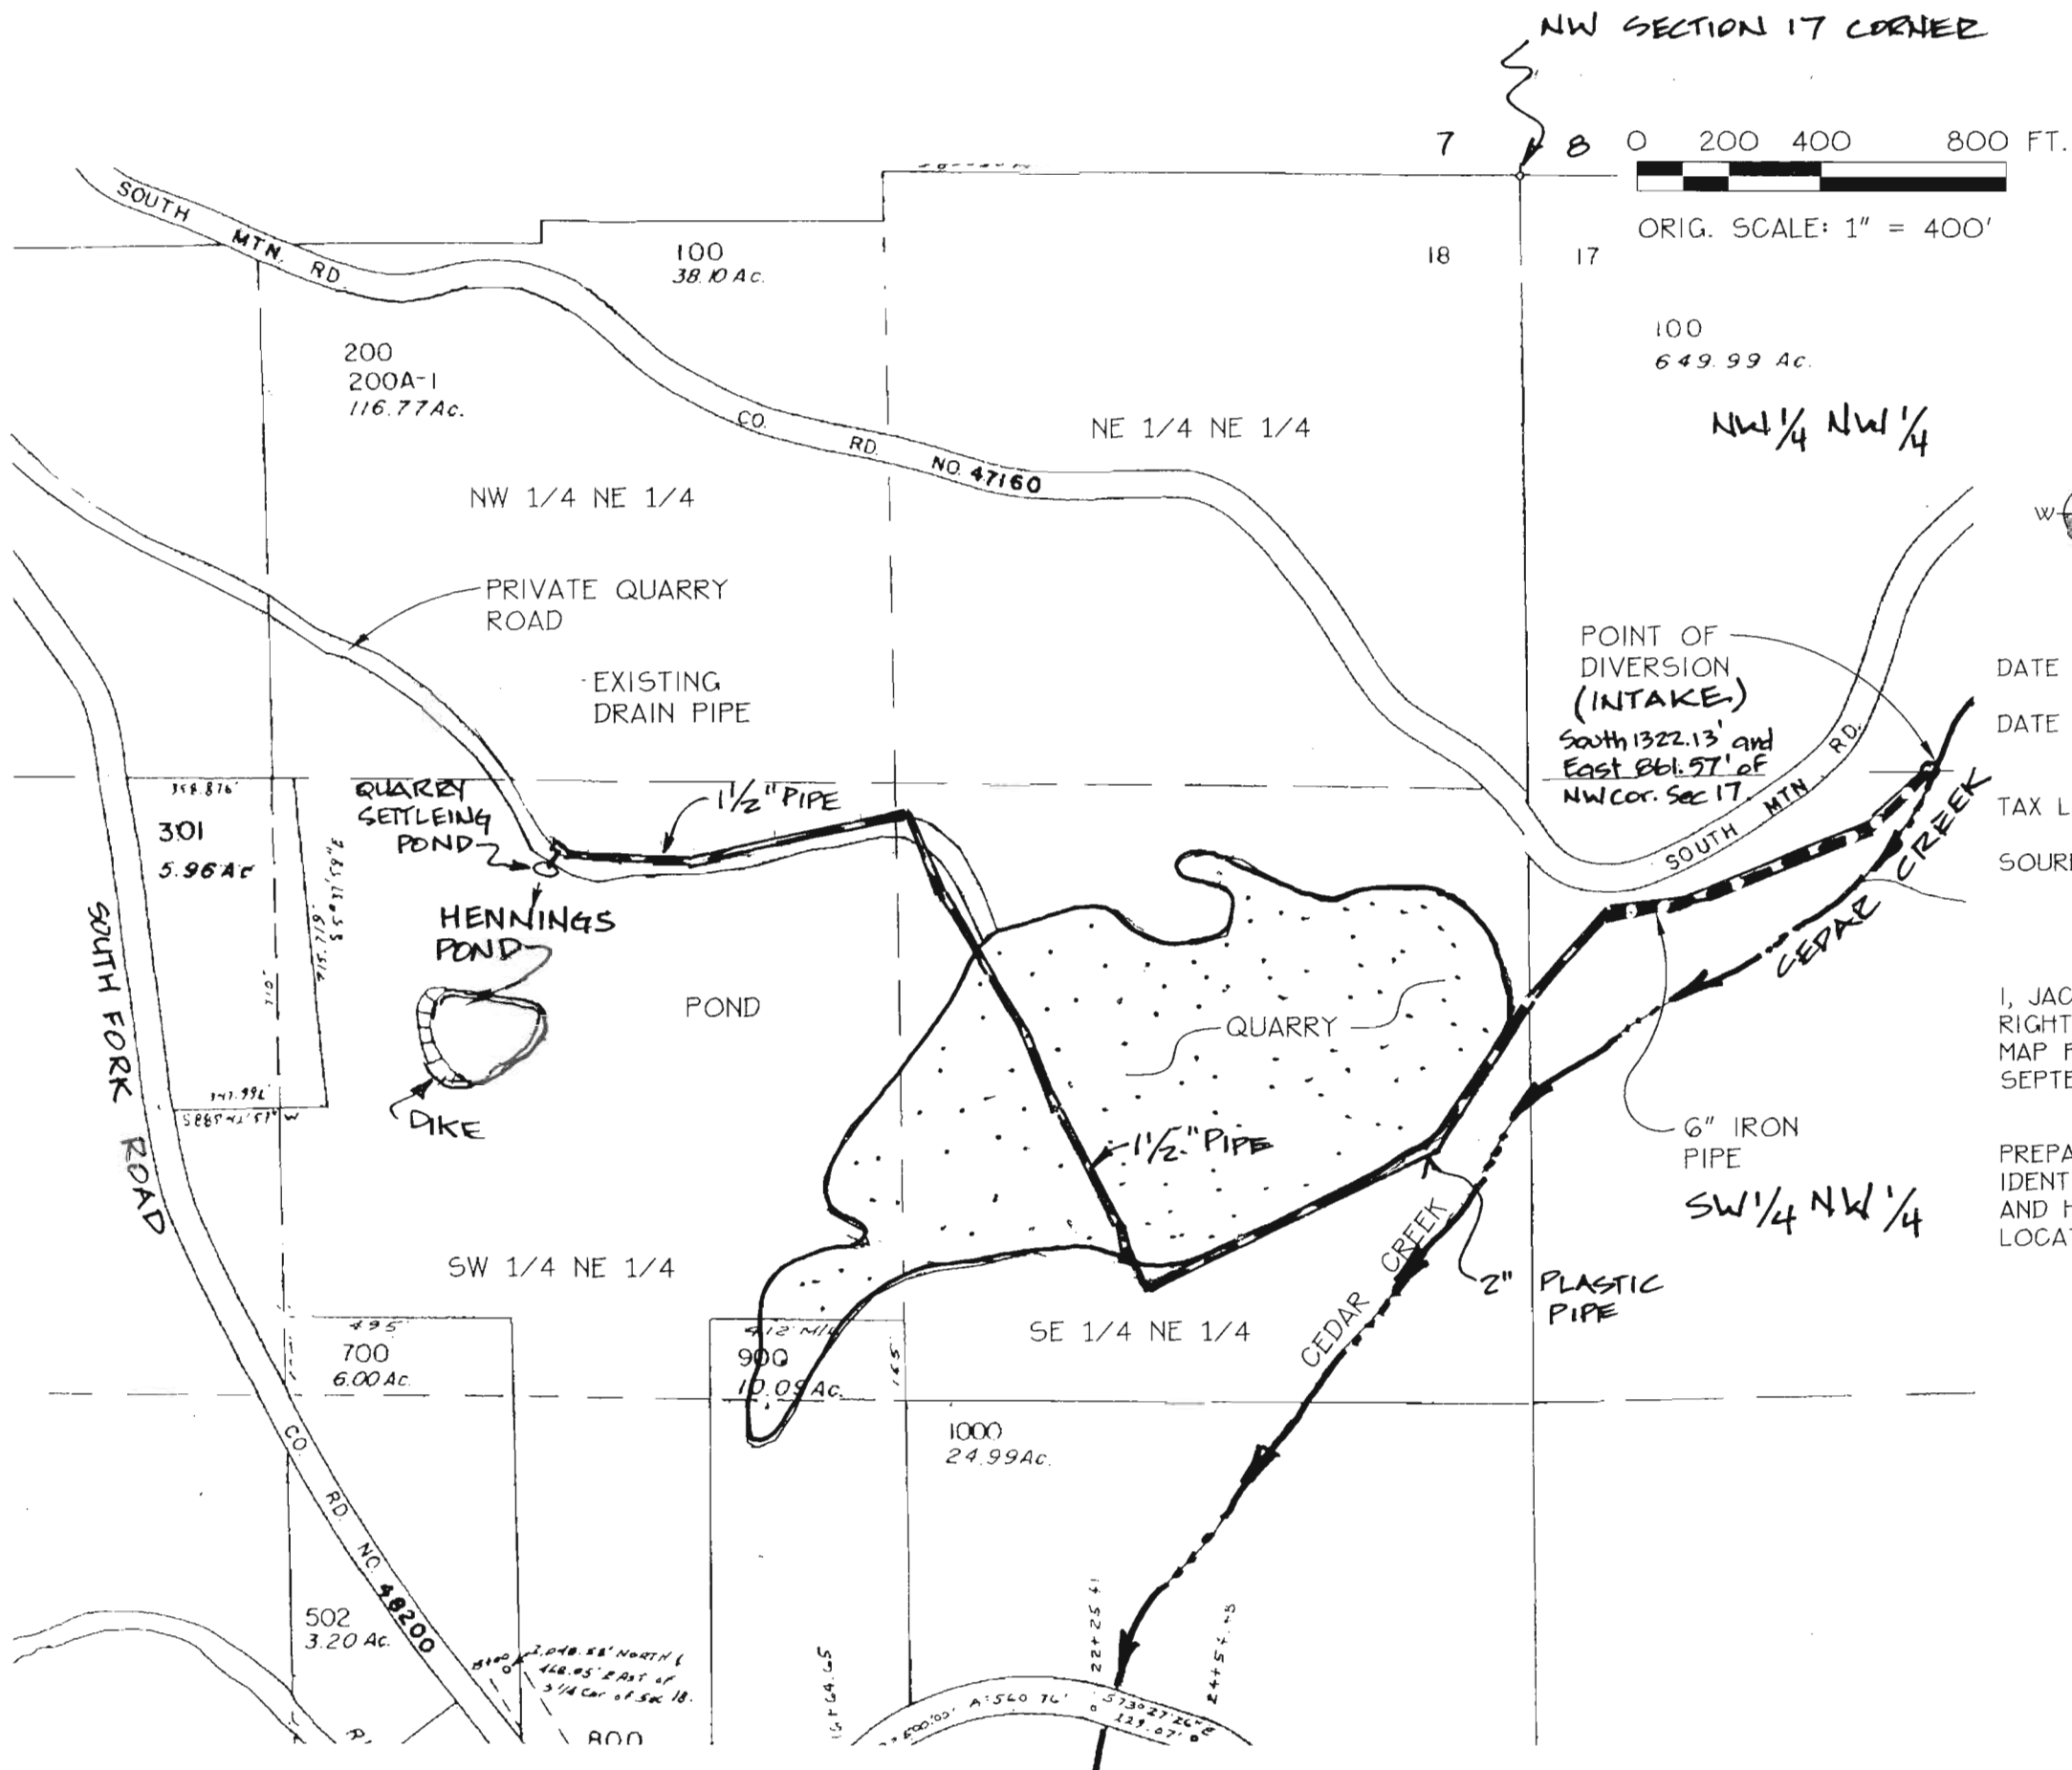

MAP OF BENEFICIAL USE
 UNDER
 PERMIT No. R-11532 + PERMIT No. 51593
 IN NAME OF
GRACE HENNINGS TRUST
 C/O BILL HENNINGS, CO-TRUSTEE
 + JUDY BUTLER, CO-TRUSTEE
 1950 POPCORN ST. NW
 SALEM, OR 97304
 Located in
**SECTIONS 17 and 18, T.14S.,
 R.7W., W.M., BENTON CO., OREGON**

DATE OF SITE INSPECTION: SEPTEMBER 23, 2003
 DATE OF MAP: SEPTEMBER 30, 2003
 TAX LOT: 200 (14-7W-18)
 SOURCE CEDAR CREEK, A TRIBUTARY OF SOUTH FORK
 ALSEA RIVER

I, JACK R. BURRELL, BEING DULY SWORN AS A WATER
 RIGHT EXAMINER, LICENSE No.209, HAVE PREPARED THIS
 MAP FOR GRACE HENNINGS TRUST ON THIS 30th DAY OF
 SEPTEMBER 2003.
 PREPARATION OF THIS MAP IS FOR THE PURPOSE OF
 IDENTIFYING THE LOCATION OF THE WATER RIGHT ONLY
 AND HAS NO INTENT TO PROVIDE DIMENSIONS OF
 LOCATION OF PROPERTY OWNERSHIP LINES.

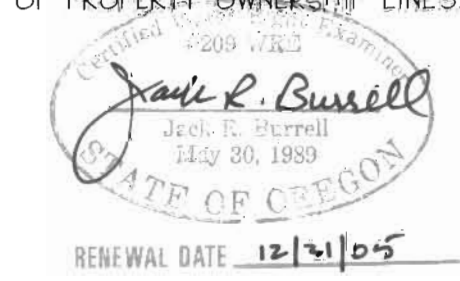

K & D ENGINEERING, Inc.
 276 N.W. Hickory Street P.O. Box 725
 Albany, Oregon 97321
 (541) 928-2583

Date: 9/30/2003 Time: 14:29
 View: PLOT Scale: 1=400
 File: dwg\02-149\149wr.dwg (Justin Miller)