


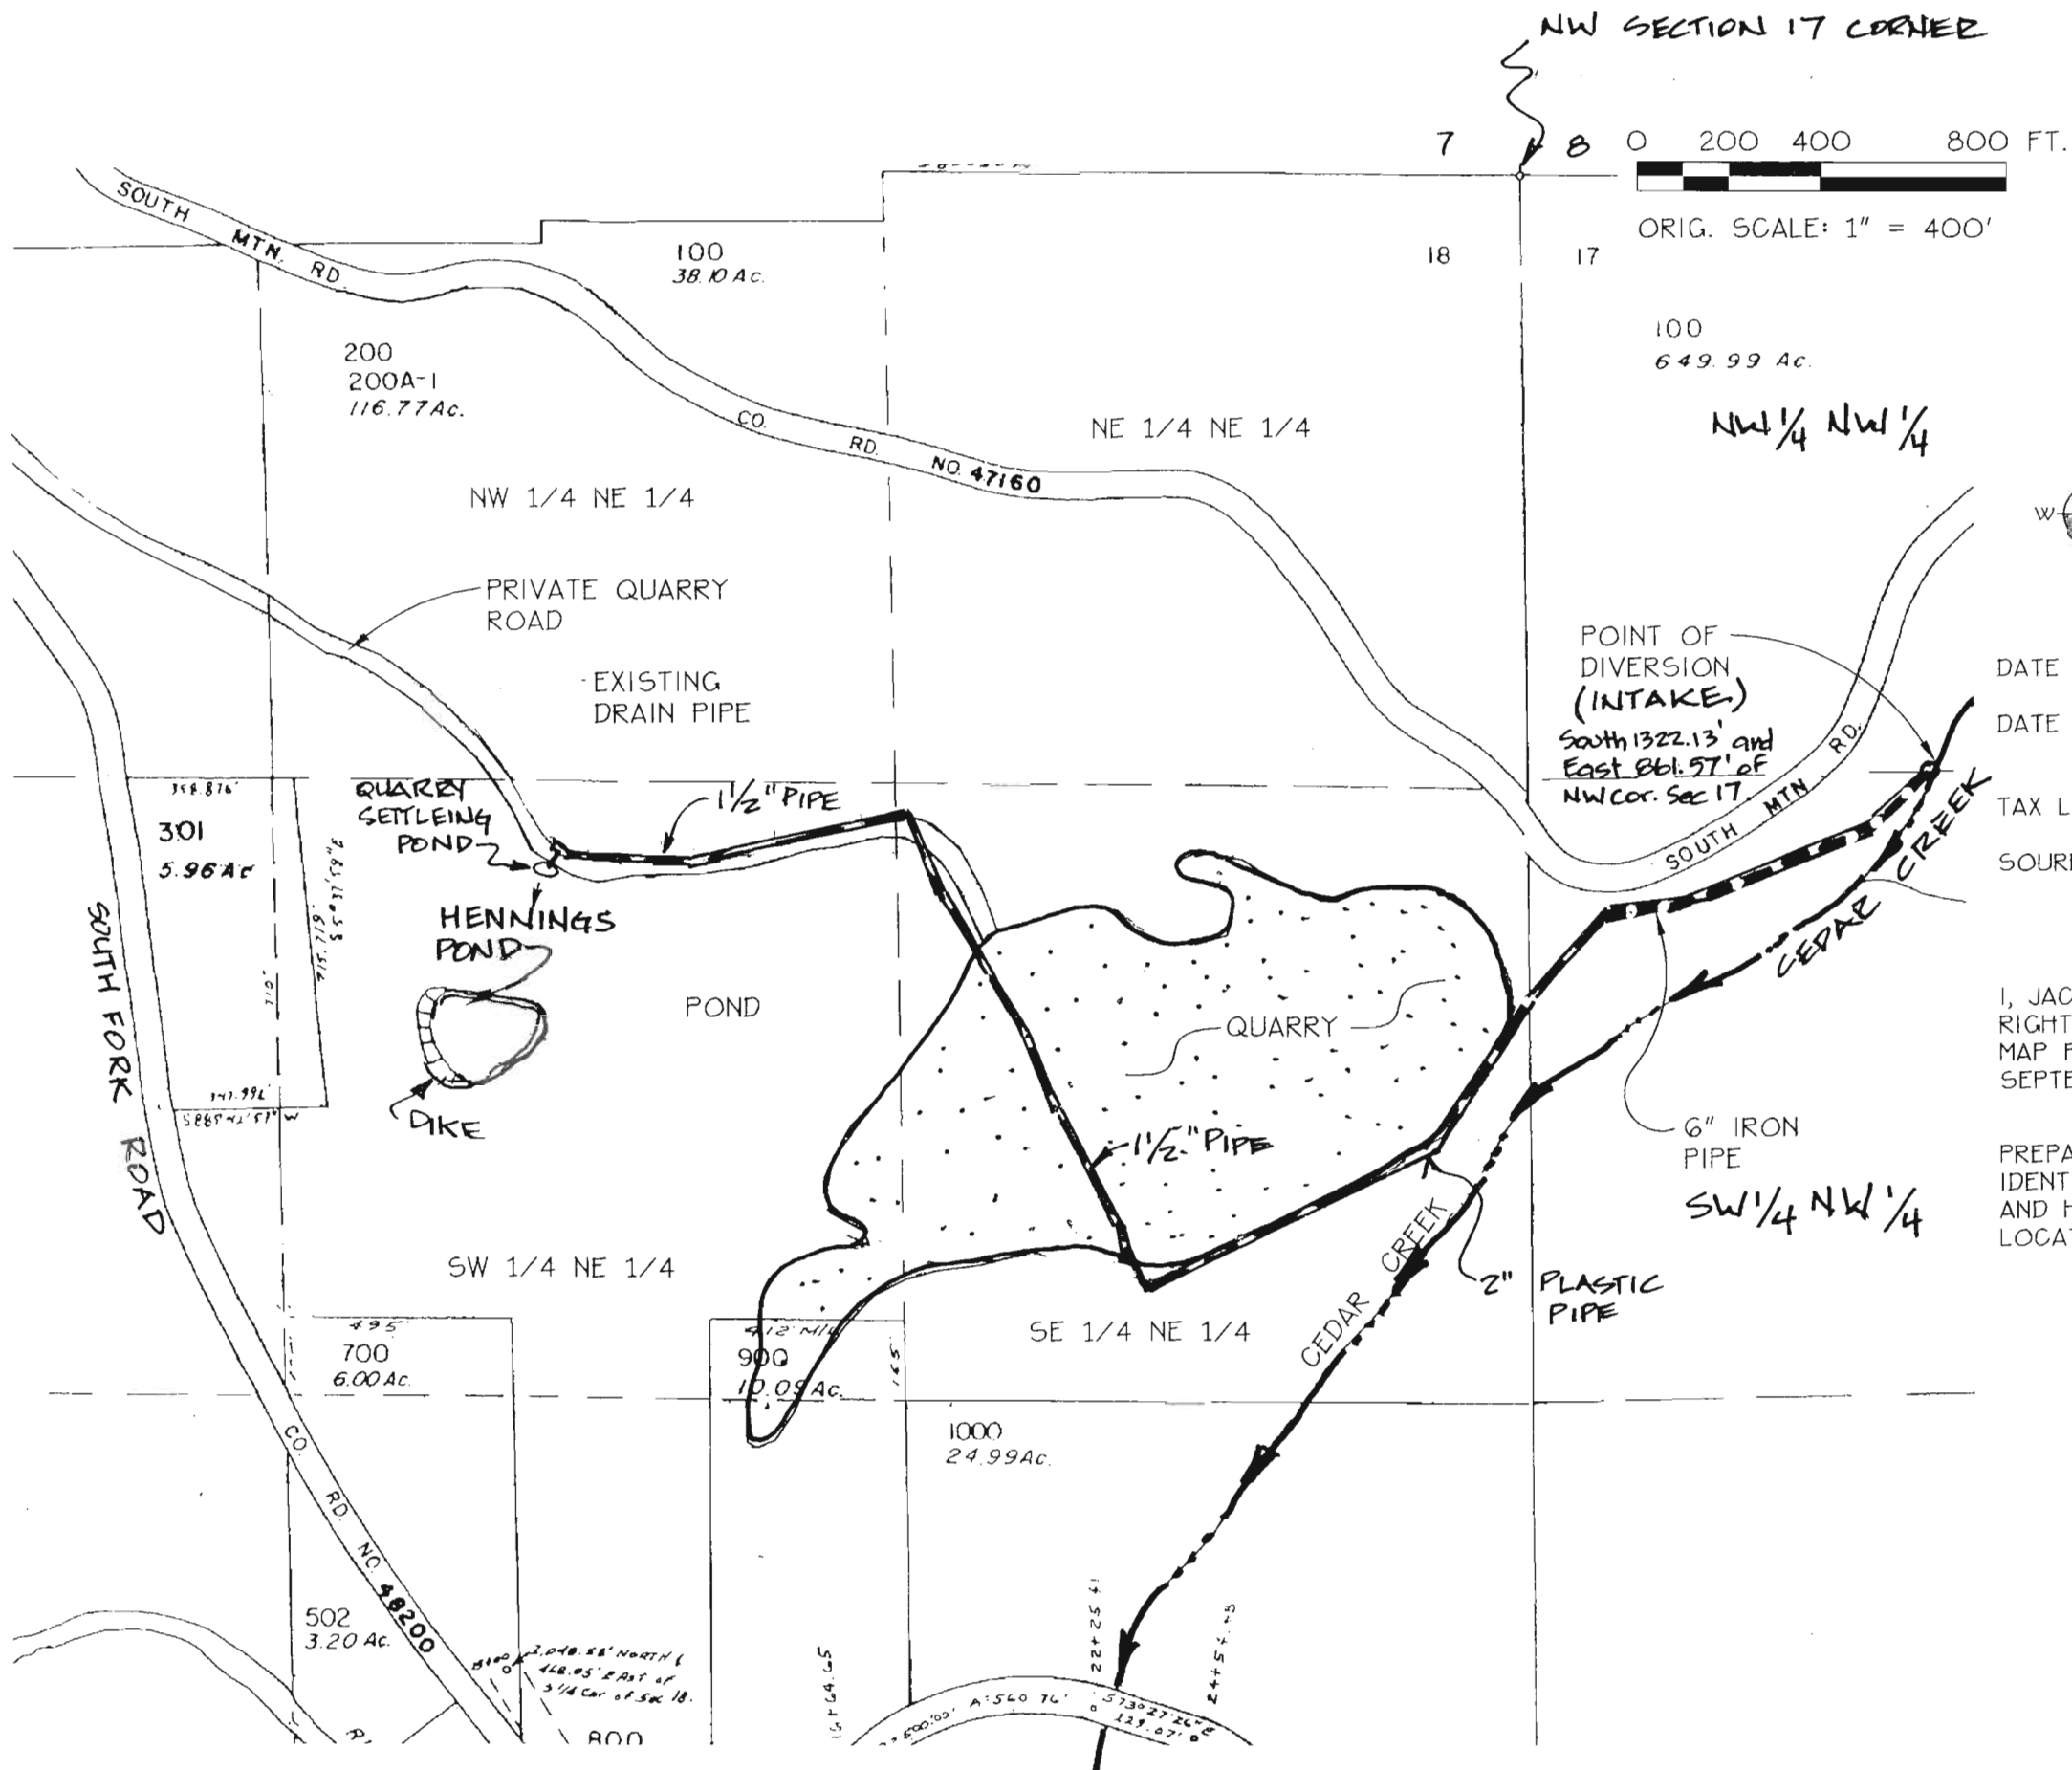

MAP OF BENEFICIAL USE
UNDER
PERMIT No. R-11532 + PERMIT No. 51593

IN NAME OF
GRACE HENNINGS TRUST
C/O BILL HENNINGS, CO-TRUSTEE
+ JUDY BUTLER, CO-TRUSTEE
1950 POPCORN ST. NW
SALEM, OR 97304

Located in
**SECTIONS 17 and 18, T.14S.,
R.7W., W.M., BENTON CO., OREGON**


DATE OF SITE INSPECTION: SEPTEMBER 23, 2003
DATE OF MAP: SEPTEMBER 30, 2003

TAX LOT: 200 (14-7W-18)

SOURCE CEDAR CREEK, A TRIBUTARY OF SOUTH FORK
ALSEA RIVER

I, JACK R. BURRELL, BEING DULY SWORN AS A WATER
RIGHT EXAMINER, LICENSE No.209, HAVE PREPARED THIS
MAP FOR GRACE HENNINGS TRUST ON THIS 30th DAY OF
SEPTEMBER 2003.

PREPARATION OF THIS MAP IS FOR THE PURPOSE OF
IDENTIFYING THE LOCATION OF THE WATER RIGHT ONLY
AND HAS NO INTENT TO PROVIDE DIMENSIONS OF
LOCATION OF PROPERTY OWNERSHIP LINES.

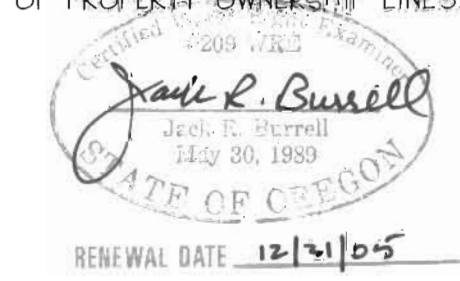

K & D ENGINEERING, Inc.
276 N.W. Hickory Street P.O. Box 725
Albany, Oregon 97321
(541) 928-2583

Date: 9/30/2003 Time: 14:29
View: PLOT Scale: 1=400
File: dwg\02-149\149wr.dwg (Justin Miller)