


T. 25 S., R. 3 W., W.M., Section 23

Diversion is:
361 ft. North and
128 ft. East of the
SW cor. Sec 23

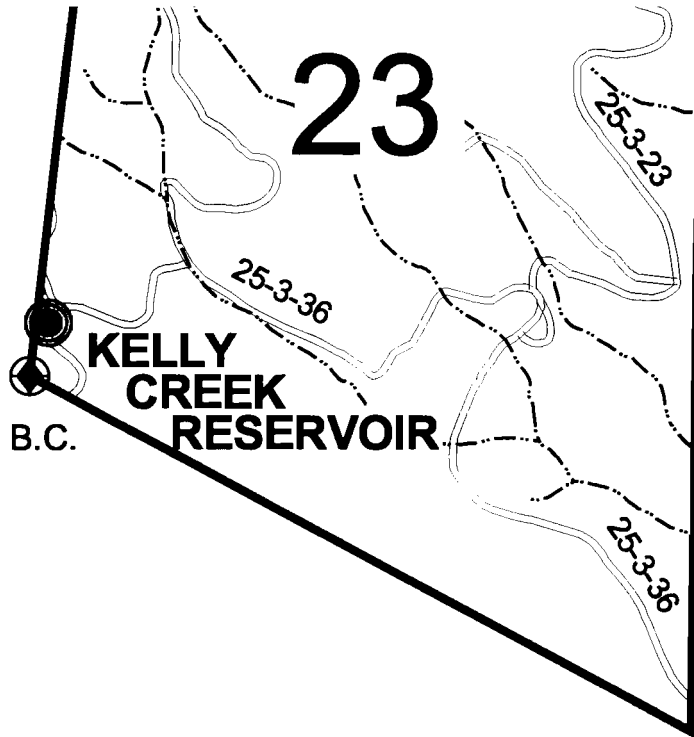

SCALE:
1" = 1320'

CLAIM OF BENEFICIAL USE MAP

in name of


UNITED STATES BUREAU OF LAND MANAGEMENT

Application No.: R - 71844

S - 71845

Permit No.: R - 11806

52258

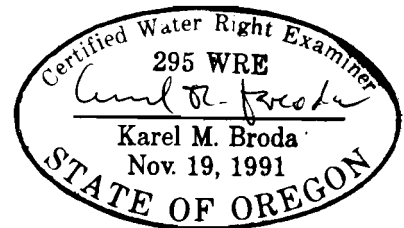

Expires: 12/31/01

SURVEYED: May 9, 2000


THIS MAP WAS PREPARED FOR THE PUPOSE OF IDENTIFYING THE LOCATION OF A WATER RIGHT ONLY
AND IS NOT INTENDED TO PROVIDE LEGAL DIMENSIONS OR LOCATION OF PROPERTY OWNERSHIP LINES.

U.S. Bureau of Land Management
Roseburg District Office
Division of Operations

Executed by:
Karel M. Broda, PE, CWRE
777 N.W. Garden Valley Blvd.
Roseburg, Oregon 97470

Application No. ^R71844
Permit No. R11806

FINAL PROOF MAP

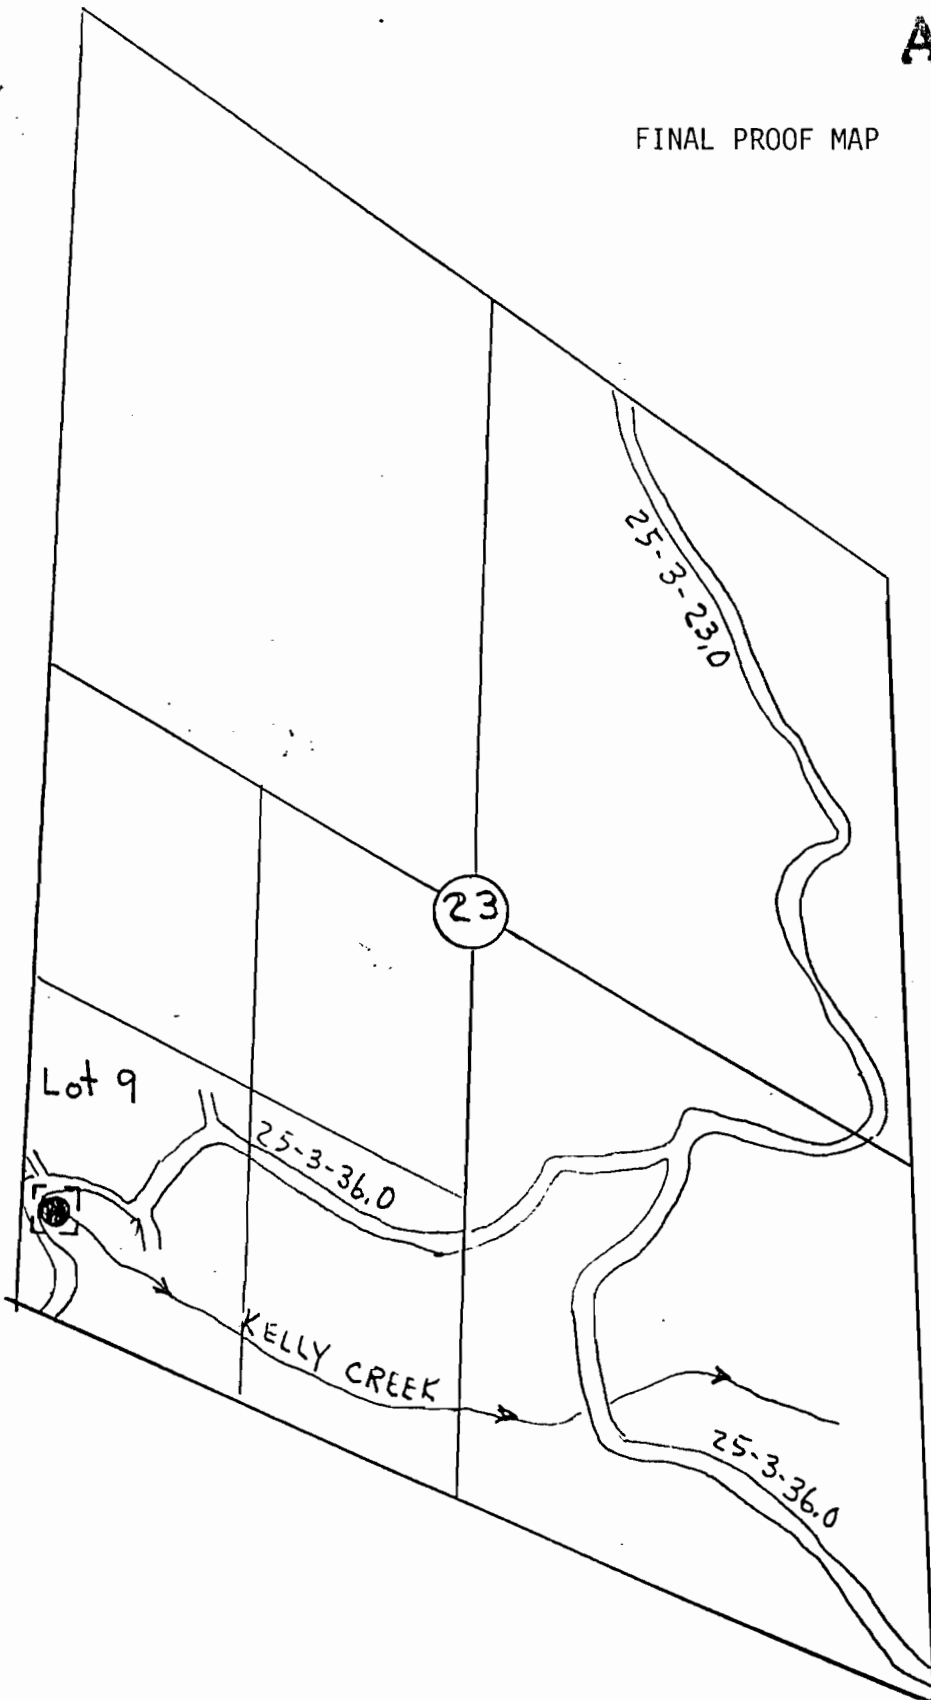


Scale 1" = 1000'

KELLY CREEK
T25S R3W Sec 23
Lot 9

The point of diversion is located 500 ft North and 200 ft East from the Southwest Section corner of Section 23.

Coordinate Ties are based on aerial photo 7-39A-13.

The map is shown for the purpose of water application and not property boundary.

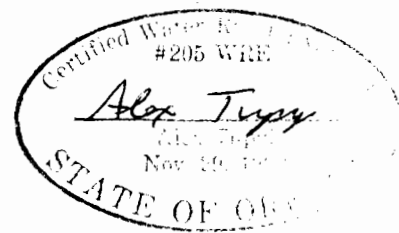

4-22-91