


T. 25 S., R. 3 W., W.M., Section 23

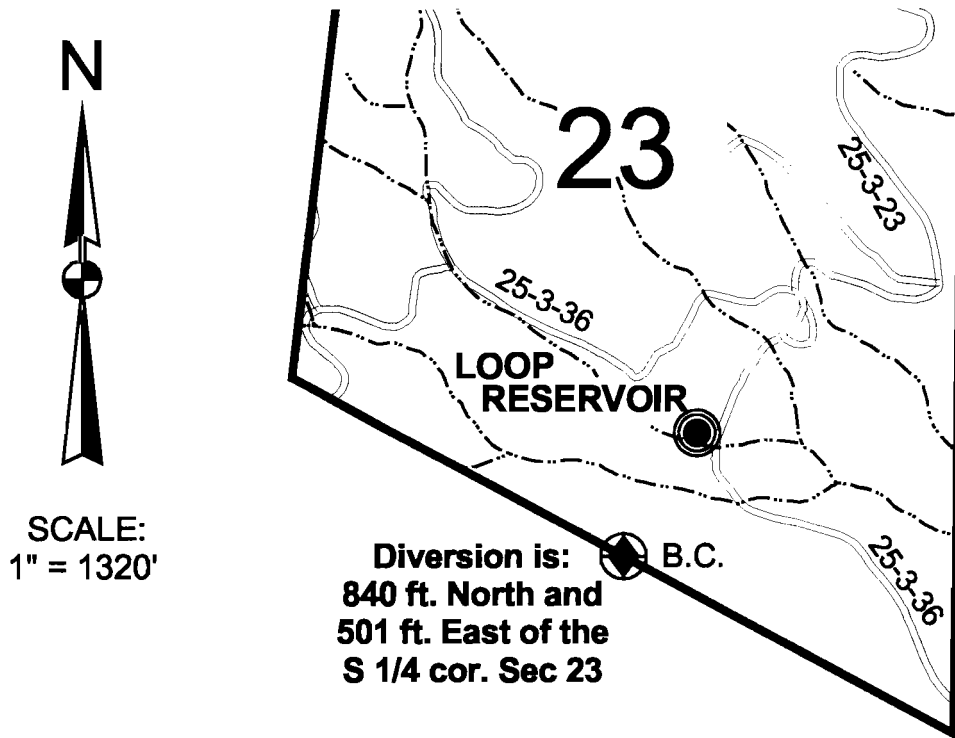


CLAIM OF BENEFICIAL USE MAP

in name of

UNITED STATES BUREAU OF LAND MANAGEMENT

RECEIVED
SEP 25 2000
WATER RESOURCES DEPT.
SALEM, OREGON

Application No.: R - 71846
S - 71847
Permit No.: R - 11795
52257

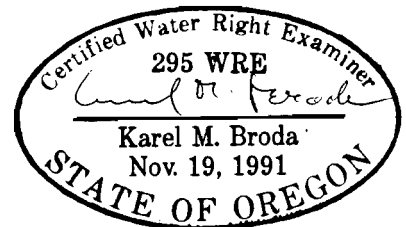

SURVEYED: May 9, 2000

Expires: 12/31/01


THIS MAP WAS PREPARED FOR THE PUPOSE OF IDENTIFYING THE LOCATION OF A WATER RIGHT ONLY
AND IS NOT INTENDED TO PROVIDE LEGAL DIMENSIONS OR LOCATION OF PROPERTY OWNERSHIP LINES.

U.S. Bureau of Land Management
Roseburg District Office
Division of Operations

Executed by:
Karel M. Broda, PE, CWRE
777 N.W. Garden Valley Blvd.
Roseburg, Oregon 97470

Application No. R-71846
Permit No. R11795

FINAL PROOF MAP

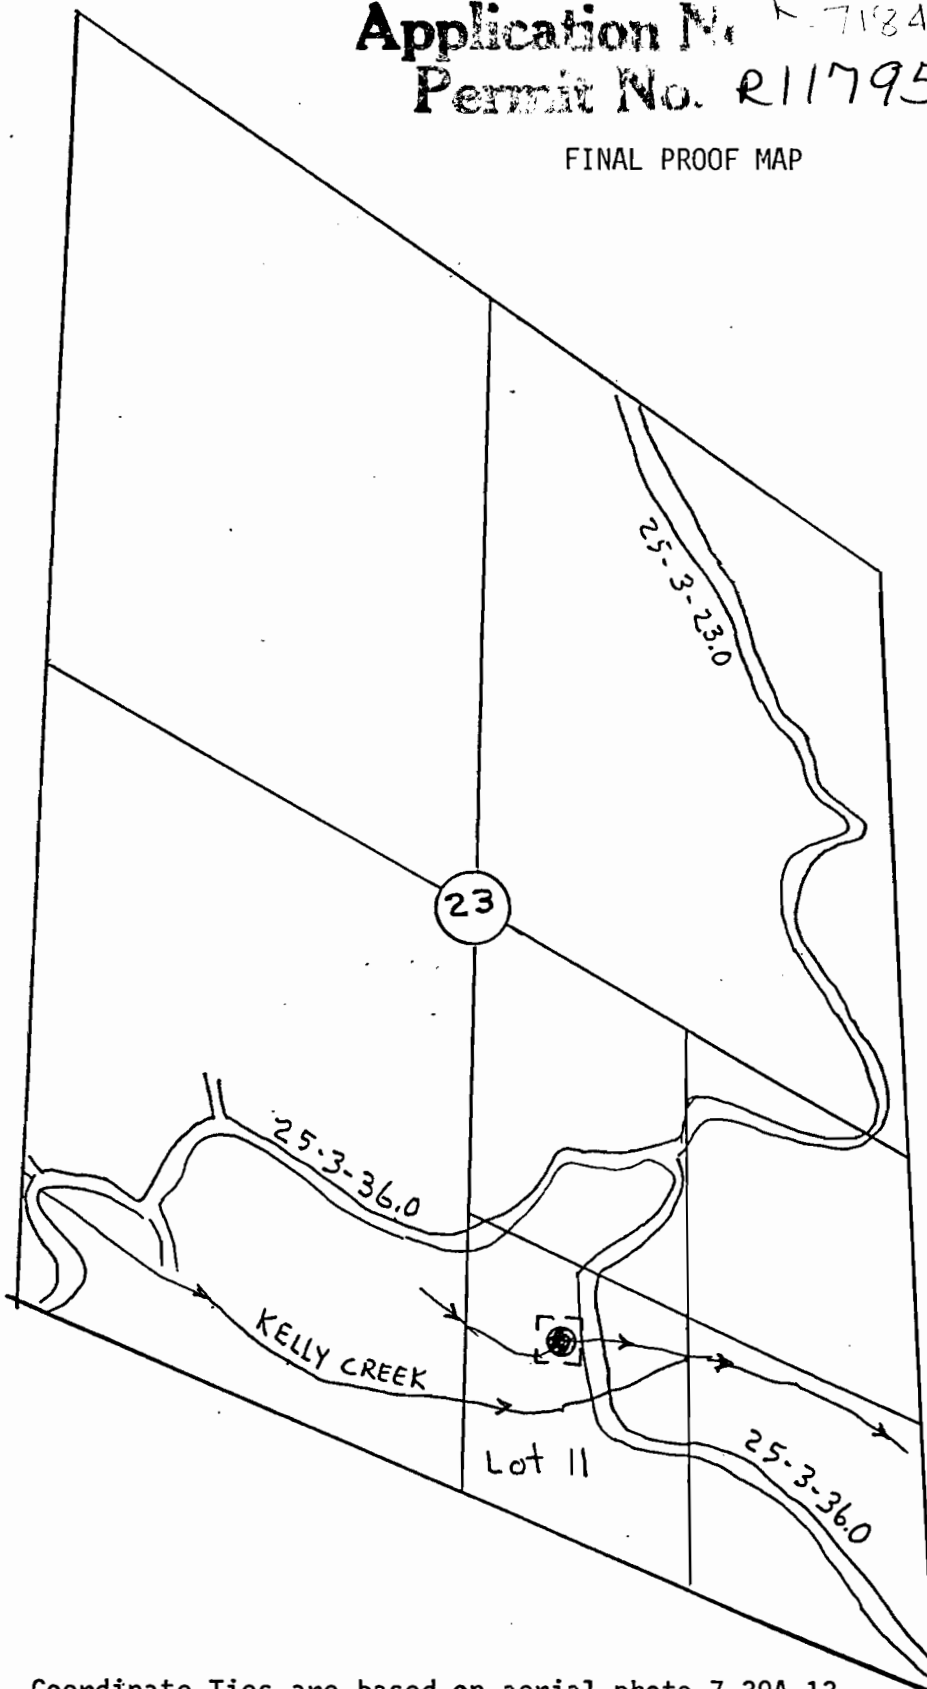

Scale 1" = 1000'

LOOP
T25S R3W Sec 23
Lot 11

Coordinate Ties are based on aerial photo 7-39A-13.

The point of diversion is located 1900 ft North and 1800 ft West from the Southeast Section corner of Section 23.

The map is shown for the purpose of water application and not property boundary.

