


T. 24 S., R. 1 W., W.M., Section 29

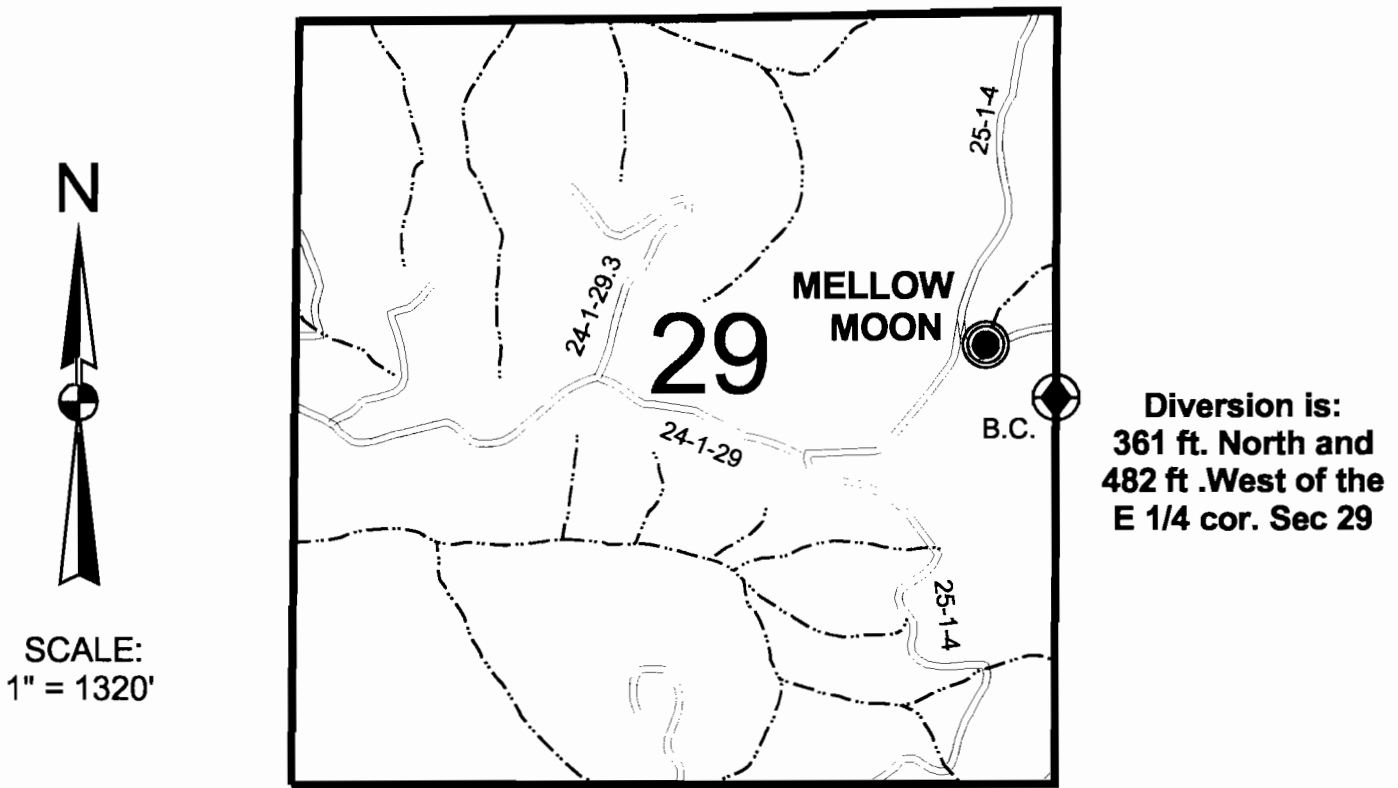

CLAIM OF BENEFICIAL USE MAP

in name of

UNITED STATES BUREAU OF LAND MANAGEMENT

Application No.: R - 71850

S - 71851

RECEIVED

Permit No.: R - 11758

51980

SEP 25 2000

WATER RESOURCES DEPT.
SALEM, OREGON

SURVEYED: May 18, 2000




Expires: 12/31/01

THIS MAP WAS PREPARED FOR THE PUPOSE OF IDENTIFYING THE LOCATION OF A WATER RIGHT ONLY
AND IS NOT INTENDED TO PROVIDE LEGAL DIMENSIONS OR LOCATION OF PROPERTY OWNERSHIP LINES.

U.S. Bureau of Land Management
Roseburg District Office
Division of Operations

Executed by:
Karel M. Broda, PE, CWRE
777 N.W. Garden Valley Blvd.
Roseburg, Oregon 97470

Application No. ^{R-71850}
 Permit No. R11758

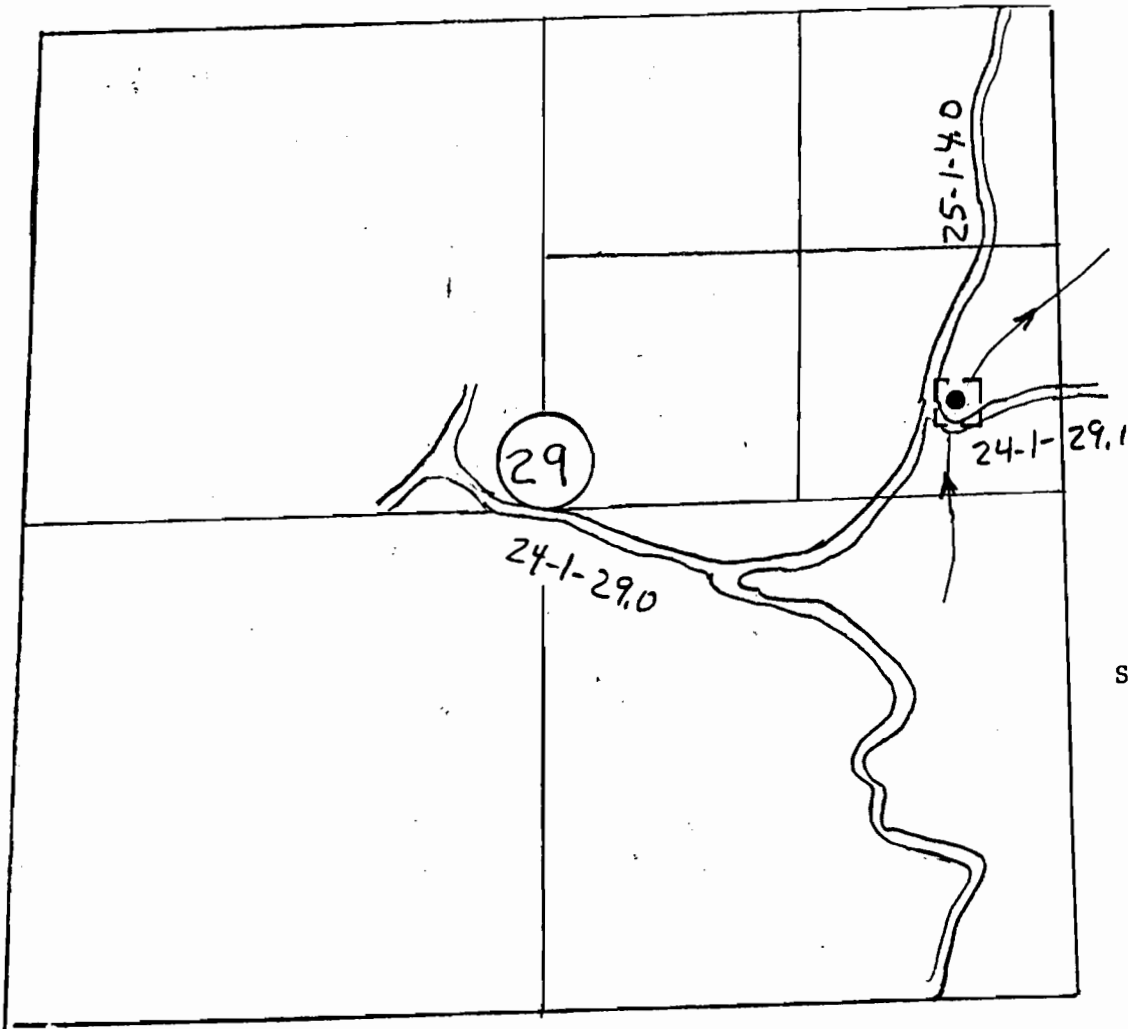


Scale 1" = 1000'

Mellow Moon Springs Pond
 T24S R1W Sec29
 SE $\frac{1}{4}$, NE $\frac{1}{4}$

The point of diversion is located approximately 3100 feet North and 550 feet West from the Southeast Section Corner of Section 29.

Coordinate Ties are based on aerial photo 9-49-13.

The map is shown for the purpose of water application and not property boundary.

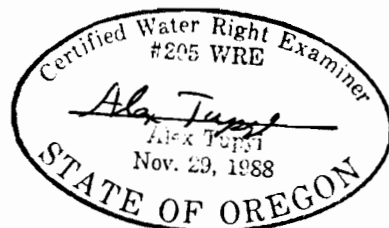

7-9-91