
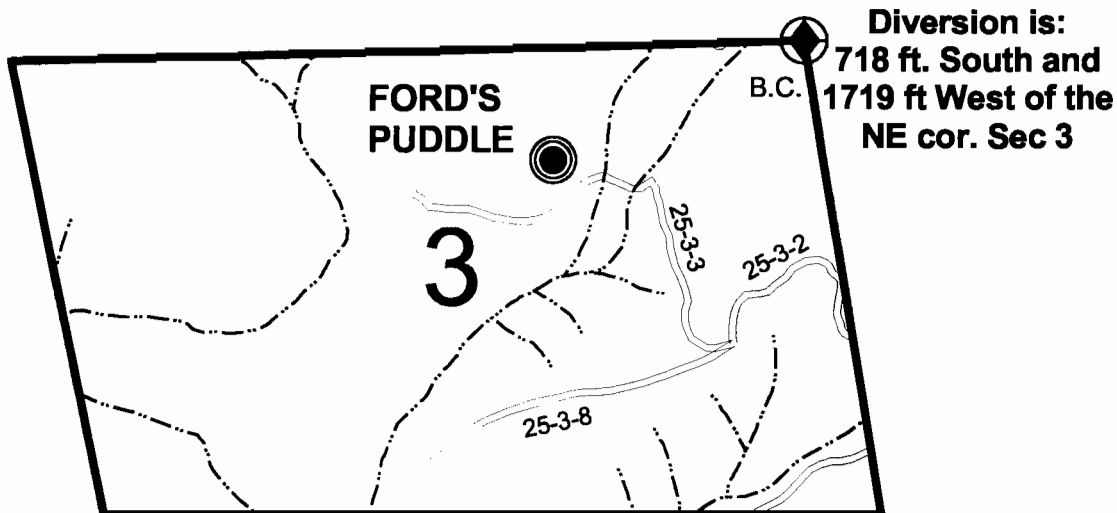


T. 25 S., R. 3 W., W.M., Section 3

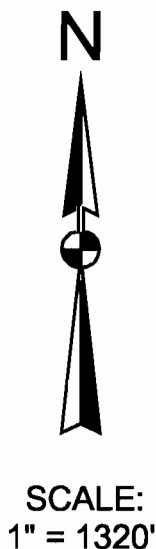

CLAIM OF BENEFICIAL USE MAP

in name of

UNITED STATES BUREAU OF LAND MANAGEMENT

Application No.: R - 71856


S - 71857

RECEIVED Permit No.: R - 11805
52284

SEP 25 2000

WATER RESOURCES DEPT.
SALEM, OREGON

SURVEYED: May 23, 2000

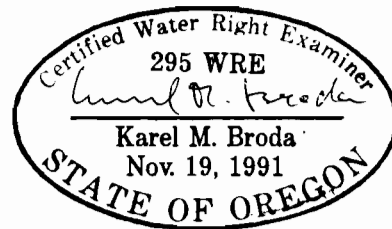

Expires: 12/31/01


THIS MAP WAS PREPARED FOR THE PUPOSE OF IDENTIFYING THE LOCATION OF A WATER RIGHT ONLY
AND IS NOT INTENDED TO PROVIDE LEGAL DIMENSIONS OR LOCATION OF PROPERTY OWNERSHIP LINES.

U.S. Bureau of Land Management
Roseburg District Office
Division of Operations

Executed by:
Karel M. Broda, PE, CWRE
777 N.W. Garden Valley Blvd.
Roseburg, Oregon 97470

Application No. R-71856
Permit No.

FINAL PROOF MAP R11805

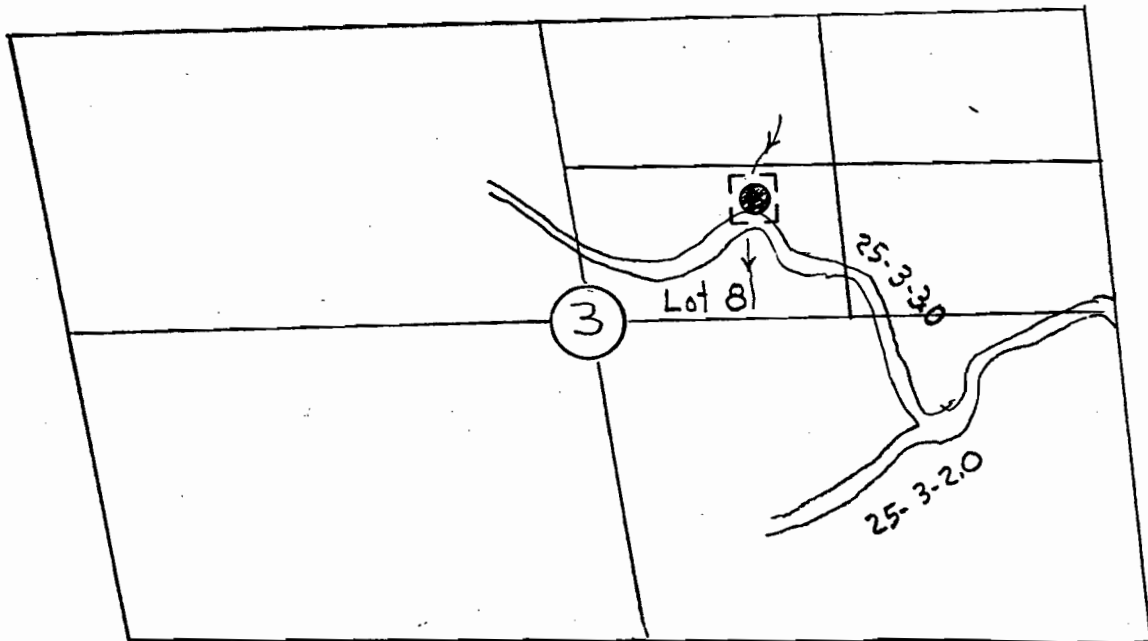


Scale 1" = 1000'

FORD'S PUDDLE
T25S R3W Sec 3
Lot 8

The point of diversion is located 900 ft South and 1700 ft West of the Northeast Section corner of Section 3.

Coordinate Ties are based on aerial photo 6-38-65.

The map is shown for the purpose of water application and not property boundary.

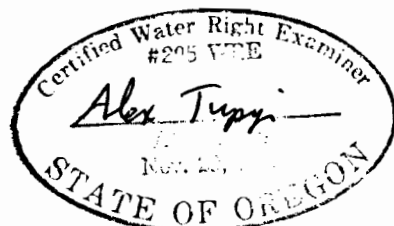

5-1-91