


T. 24 S., R. 2 W., W.M., Section 1

Diversion is:
708 ft. South and
833 ft. East of the
W 1/4 cor. Sec 1

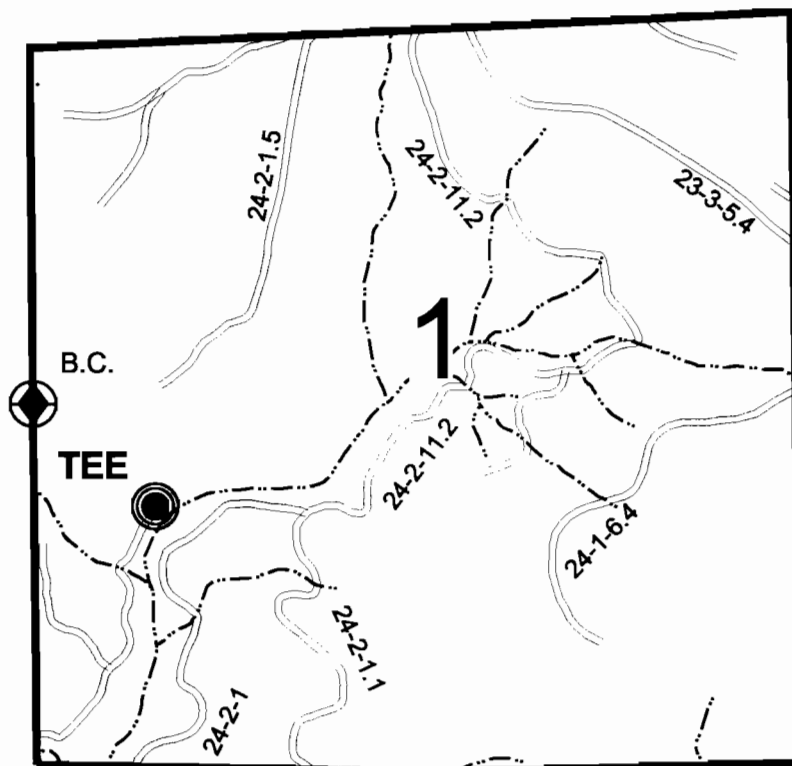

SCALE:
1" = 1320'

CLAIM OF BENEFICIAL USE MAP

in name of

UNITED STATES BUREAU OF LAND MANAGEMENT

Application No.: R - 71858

S - 71859


Permit No.: R - 12055

52818

RECEIVED

SEP 25 2000

WATER RESOURCES DEPT.
SALEM, OREGON

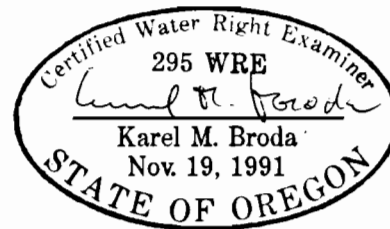

Expires: 12/31/01

SURVEYED: May 22, 2000

THIS MAP WAS PREPARED FOR THE PURPOSE OF IDENTIFYING THE LOCATION OF A WATER RIGHT ONLY
AND IS NOT INTENDED TO PROVIDE LEGAL DIMENSIONS OR LOCATION OF PROPERTY OWNERSHIP LINES.

U.S. Bureau of Land Management
Roseburg District Office
Division of Operations

Executed by:
Karel M. Broda, PE, CWRE
777 N.W. Garden Valley Blvd.
Roseburg, Oregon 97470