


T. 24 S., R. 2 W., W.M., Section 1

**Diversion is:
708 ft. South and
833 ft. East of the
W 1/4 cor. Sec 1**

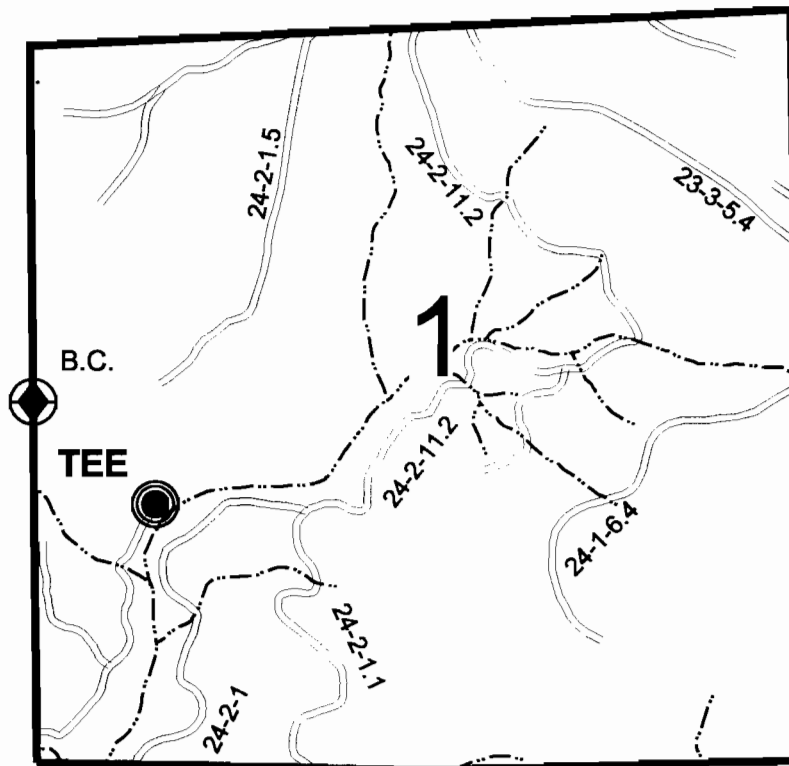

**SCALE:
1" = 1320'**

CLAIM OF BENEFICIAL USE MAP

in name of

UNITED STATES BUREAU OF LAND MANAGEMENT

Application No.: R - 71858

S - 71859

Permit No.: R - 12055


52818

RECEIVED

SEP 25 2000

**WATER RESOURCES DEPT.
SALEM, OREGON**

SURVEYED: May 22, 2000

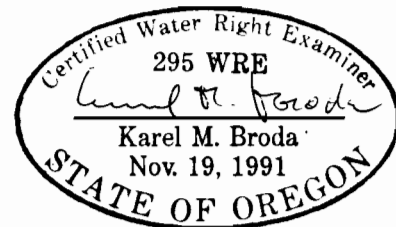


Expires: 12/31/01

**THIS MAP WAS PREPARED FOR THE PUPOSE OF IDENTIFYING THE LOCATION OF A WATER RIGHT ONLY
AND IS NOT INTENDED TO PROVIDE LEGAL DIMENSIONS OR LOCATION OF PROPERTY OWNERSHIP LINES.**

**U.S. Bureau of Land Management
Roseburg District Office
Division of Operations**

**Executed by:
Karel M. Broda, PE, CWRE
777 N.W. Garden Valley Blvd.
Roseburg, Oregon 97470**

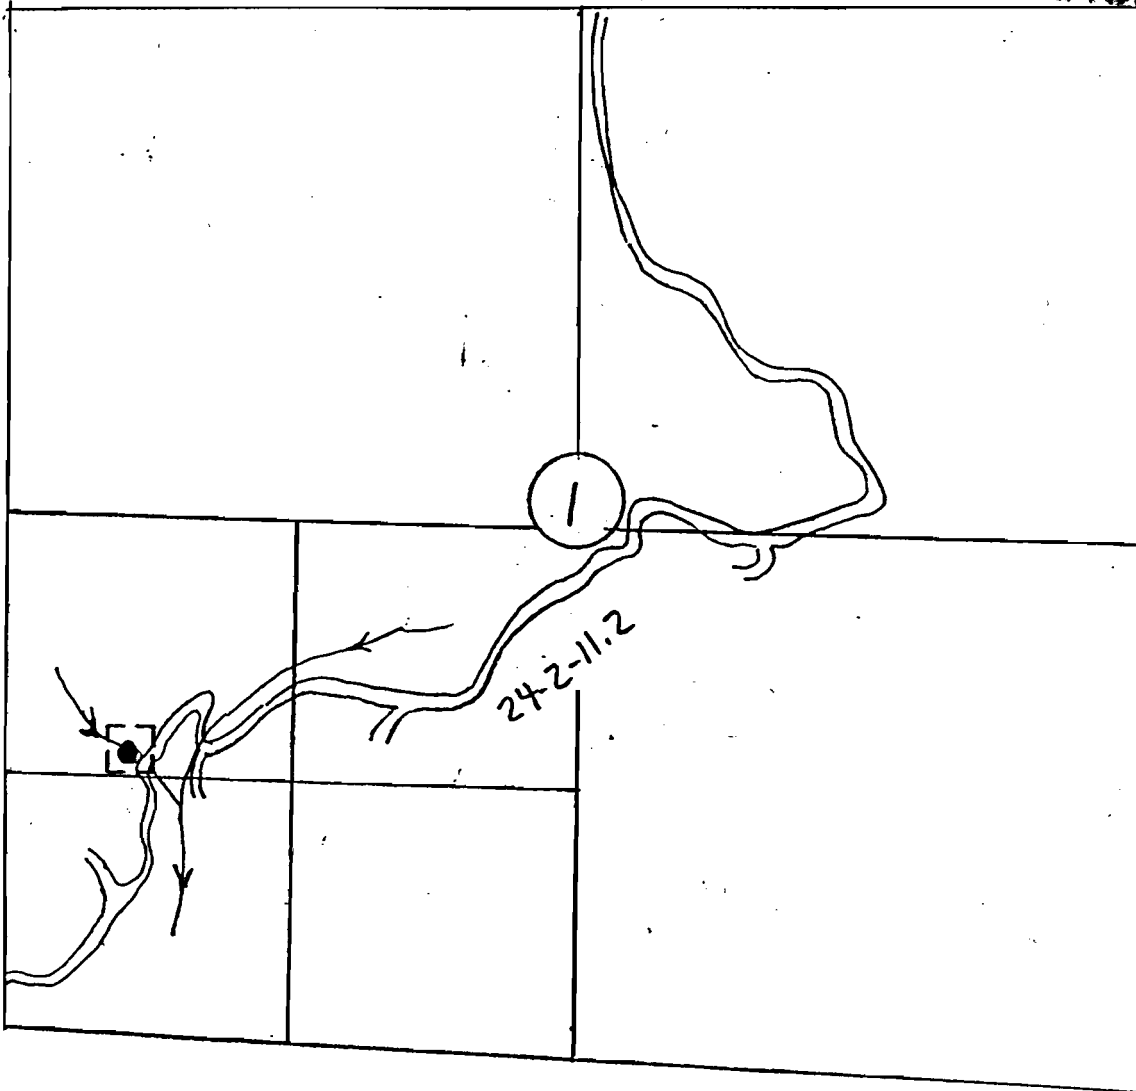Application No. 71858
Permit No. R012055


Scale 1" = 1000'

Tee Pond
T24S R2W Sec1
NW $\frac{1}{4}$, SW $\frac{1}{4}$

The point of diversion is located approximately 1450 feet North and 600 feet East from the Southwest Section Corner of Section 1.

Coordinate Ties are based on aerial 9-46A-47.

The map is shown for the purpose of water application and not property boundary.

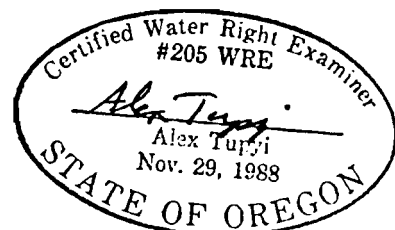

7-9-91