
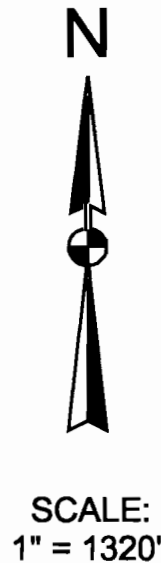


T. 32 S., R. 7 W., W.M., Section 13

**Diversion is:
951 ft. South and
1355 ft. East of the
NW cor. Sec 13**

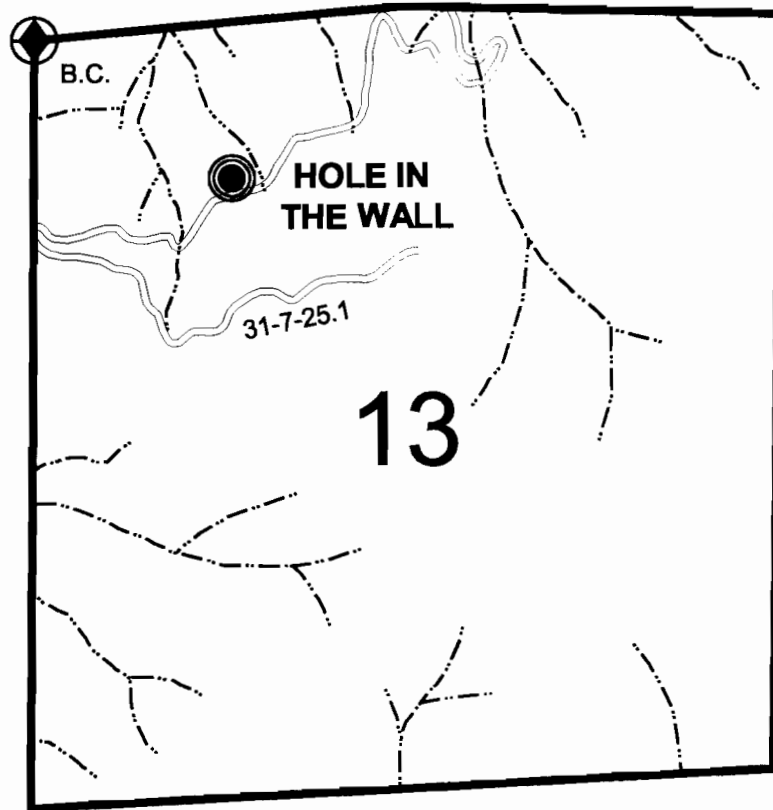

CLAIM OF BENEFICIAL USE MAP

in name of

UNITED STATES BUREAU OF LAND MANAGEMENT

Application No.: R - 71866

S - 71867

Permit No.: R - 11793

52261

RECEIVED

SEP 25 2000

WATER RESOURCES DEPT.
SALEM, OREGON

SURVEYED: June 6, 2000



Expires: 12/31/01

THIS MAP WAS PREPARED FOR THE PUPOSE OF IDENTIFYING THE LOCATION OF A WATER RIGHT ONLY
AND IS NOT INTENDED TO PROVIDE LEGAL DIMENSIONS OR LOCATION OF PROPERTY OWNERSHIP LINES.

U.S. Bureau of Land Management
Roseburg District Office
Division of Operations

Executed by:
Karel M. Broda, PE, CWRE
777 N.W. Garden Valley Blvd.
Roseburg, Oregon 97470