


FINAL PROOF SURVEY MAP IN THE NAME OF BLANCO BOGS

APPLICATION R-71873
S-71874

PERMIT R-12004
52904

SECTION 32, TOWNSHIP 31 SOUTH, RANGE 15 WEST, W.M.
AND
SECTION 5, TOWNSHIP 32 SOUTH, RANGE 15 WEST, W.M.

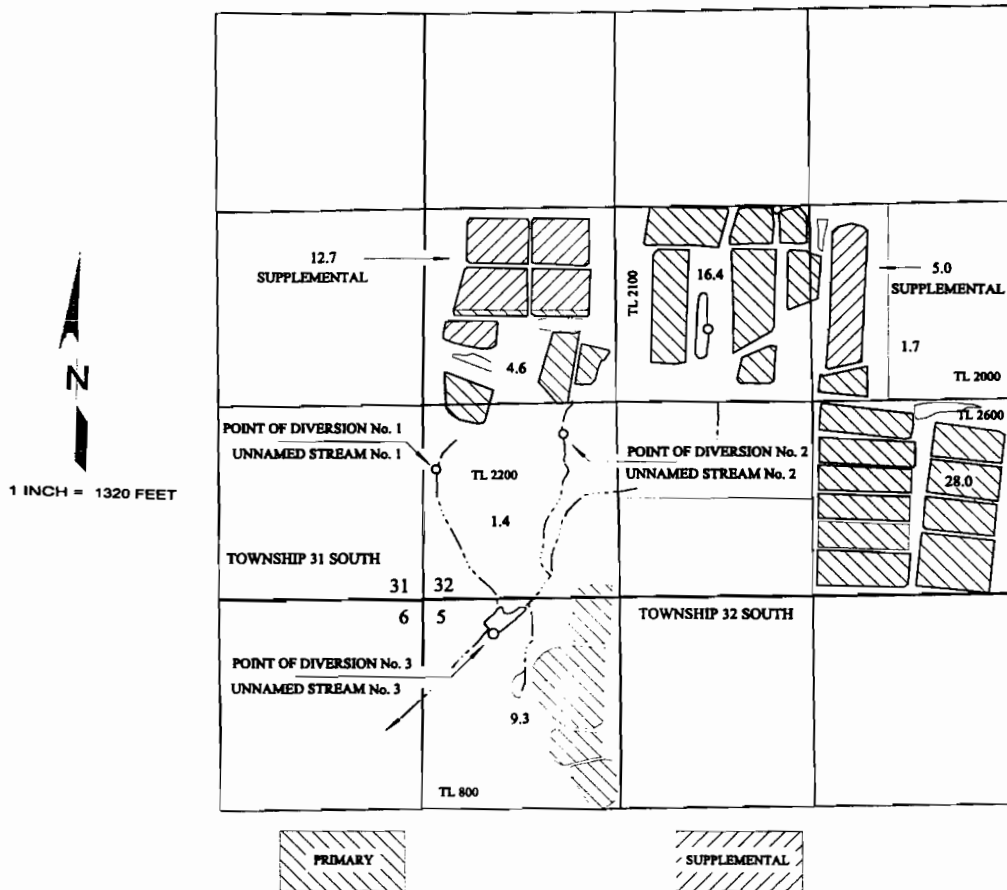


POINT OF DIVERSION No. 1 ON UNNAMED STREAM No. 1 IS LOCATED 910 FEET NORTH AND 90 FEET EAST; POINT OF DIVERSION No. 2 ON UNNAMED STREAM No. 2 IS LOCATED 1150 FEET NORTH AND 960 FEET EAST; BOTH FROM THE SOUTHWEST CORNER OF SECTION 32 ; BOTH WITHIN THE SW $\frac{1}{4}$ SW $\frac{1}{4}$ OF SECTION 32, TOWNSHIP 31 SOUTH, RANGE 15 WEST, W.M.; AND POINT OF DIVERSION No. 3 AND THE RESERVOIR ON UNNAMED STREAM No. 3 IS LOCATED 240 FEET SOUTH AND 470 FEET EAST FROM THE NORTHWEST CORNER OF SECTION 5, BEING WITHIN THE NW $\frac{1}{4}$ NW $\frac{1}{4}$ OF SECTION 5, TOWNSHIP 32 SOUTH, RANGE 15 WEST, W.M.; ALL WITHIN CURRY COUNTY.

RECEIVED

SEP 25 2000

WATER RESOURCES DEPT
SALEM, OREGON

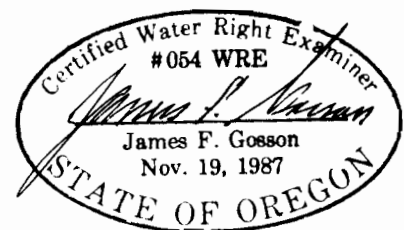

THE PURPOSE OF THIS MAP IS TO IDENTIFY THE LOCATION OF THE WATER RIGHT. IT IS NOT INTENDED TO PROVIDE INFORMATION RELATIVE TO THE LOCATION OF PROPERTY OWNERSHIP BOUNDARY LINES.