


T 6 S, R 1 W, W.M.

MARION COUNTY

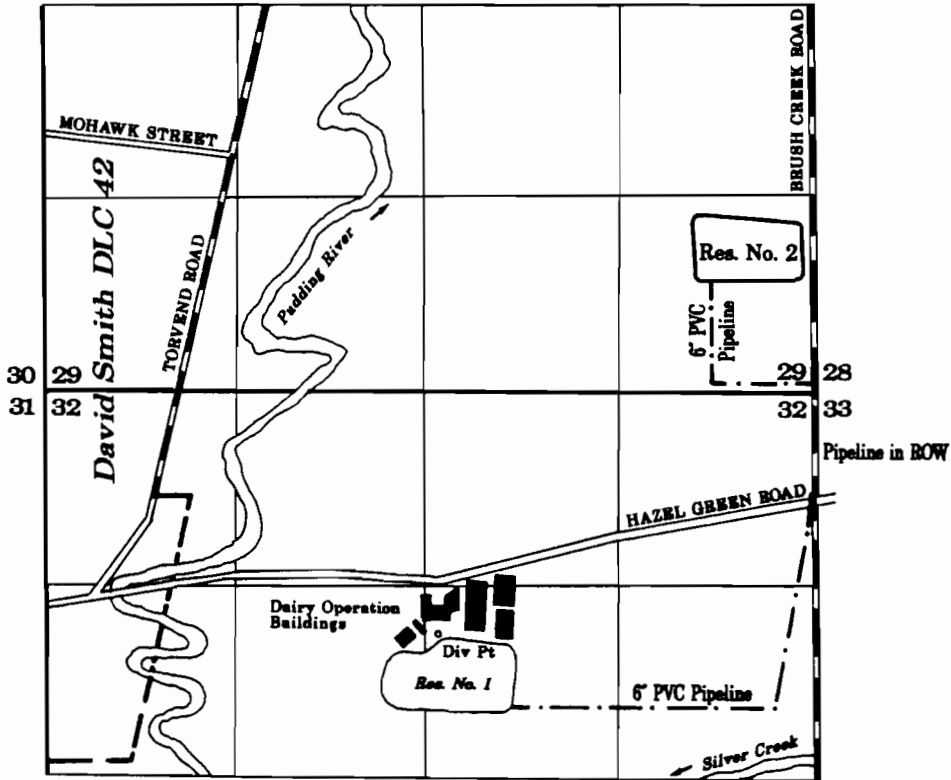

Div. Pt. 2580' West and 1660' South of the NE corner of Section 32.

FINAL PROOF SURVEY
UNDER

Application R-71914 Permit R-11534

IN THE NAME OF
MALLORIE'S DAIRY, INC.

September 17, 1999
Scale: 1" = 1320'

RECEIVED

OCT 01 1999

WATER RESOURCES DEPT
SALEM, OREGON



NOTE: This map is for the purpose of identifying the location of water rights and has no intent to locate or dimension property ownership lines.