


T8S, R2W, WM

MARION COUNTY

TAX LOTS:
8 2W 01 00600
8 2W 02A 01000

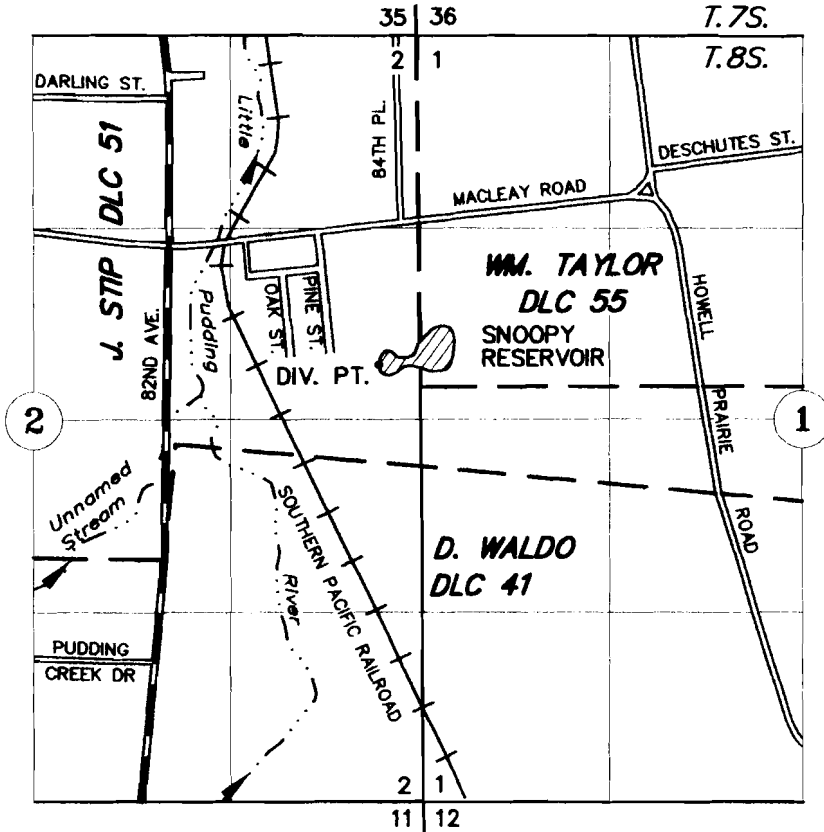

DIV. PT.: 155' NORTH AND 290' WEST OF SW COR WM. TAYLOR DLC 55.

FINAL PROOF SURVEY UNDER


Application No. R-84170

Permit No. R-12857

TIM BAUGHMAN & CAROL BAUGHMAN

RECEIVED

OCTOBER 13, 2003
SCALE: 1" = 1320'

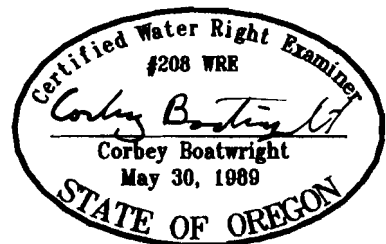

NOTE: This map is for the purpose of identifying the location of water rights and has no intent to dimension or locate property ownership lines.


EXPIRES: 12-31-2005

RECEIVED

T8S, R2W, WM

MARION COUNTY

Reservoir Centerline Cross-Section

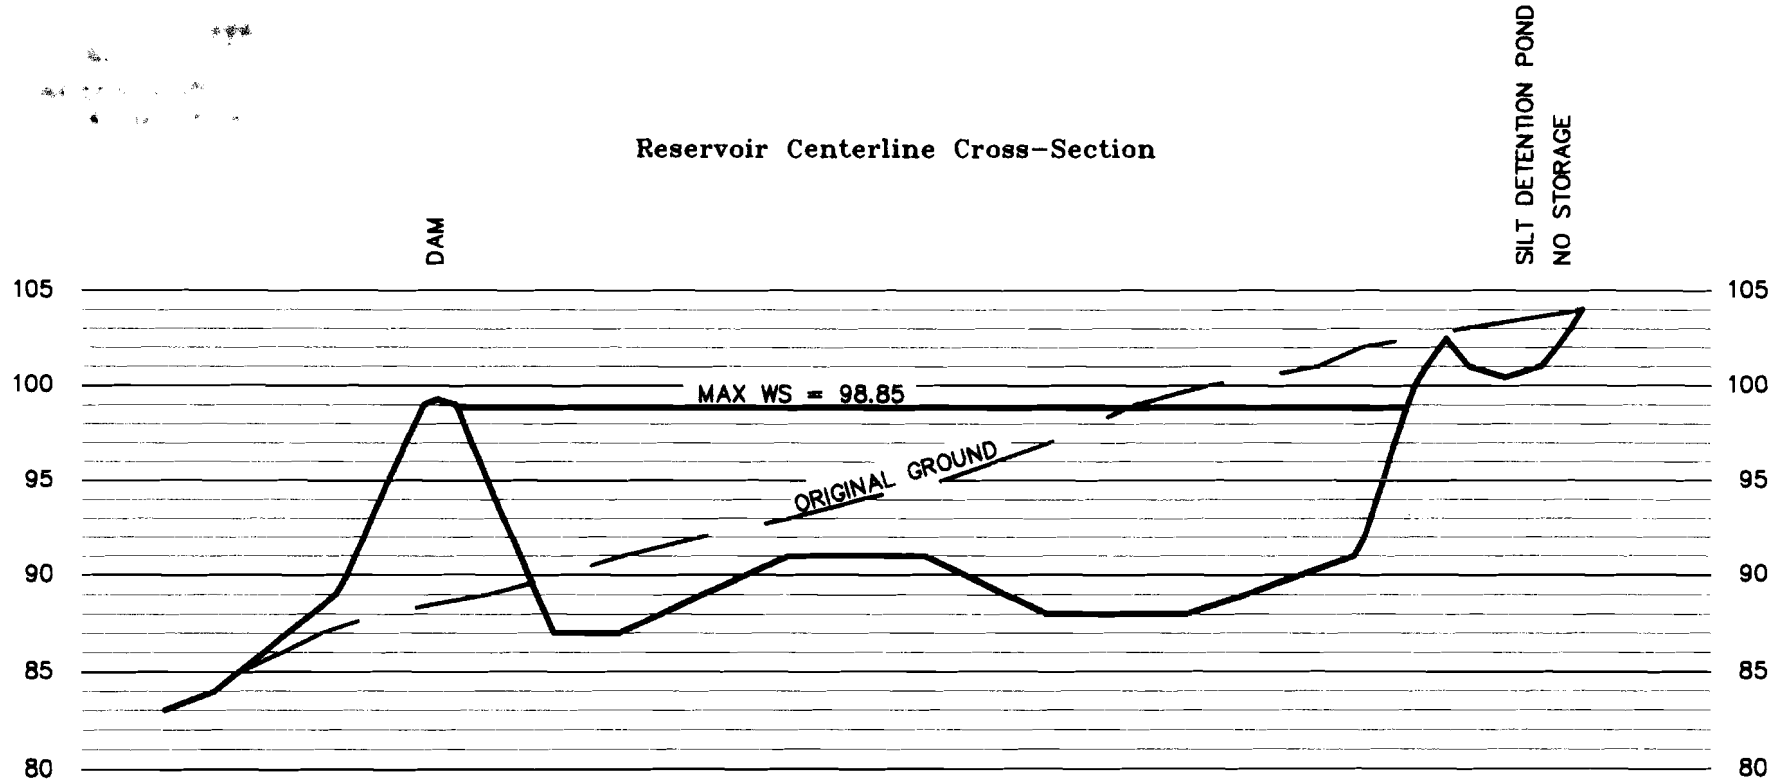

SCALE
 HORIZ: 1" = 100'
 VERT: 1" = 10'

FINAL PROOF SURVEY


UNDER

Application No. R-84170 Permit No. R-12857

TIM BAUGHMAN & CAROL BAUGHMAN

OCTOBER 13, 2003

SCALE 1" = 100'

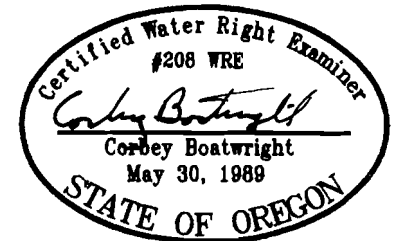

EXPIRES: 12-31-2005

T8S, R2W, WM


MARION COUNTY

AREA CAPACITY CURVE

RECEIVED

ACRE-FOOT

SCALE: HORZ. 1" = 4 ACRE-FOOT
VERT. 1" = 4'

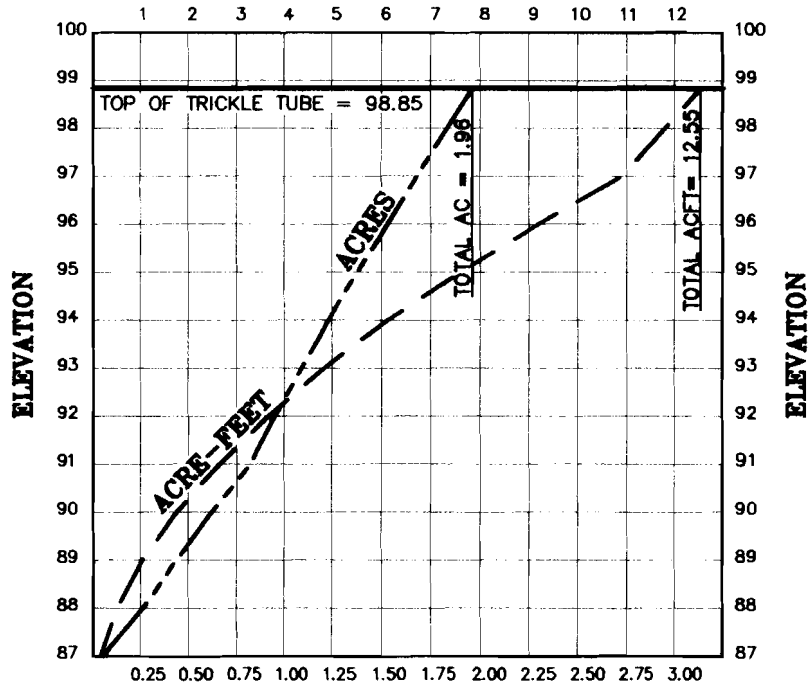

ACRES

SCALE: HORZ. 1" = 1.0 ACRES
VERT. 1" = 4'

FINAL PROOF SURVEY


UNDER

Application No. R-84170

Permit No. R-12857

TIM BAUGHMAN & CAROL BAUGHMAN

OCTOBER 13, 2003

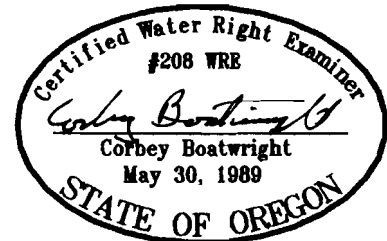

EXPIRES: 12-31-2005

NOTE: This map is for the purpose of identifying the location of water rights and has no intent to dimension or locate property ownership lines.

T8S, R2W, WM

MARION COUNTY


SECTION 2

SECTION 1

MAP 08 2W 01
TAX LOT 600

MAP 08 2W 02A
TAX LOT 1000

MAX WS = 98.85

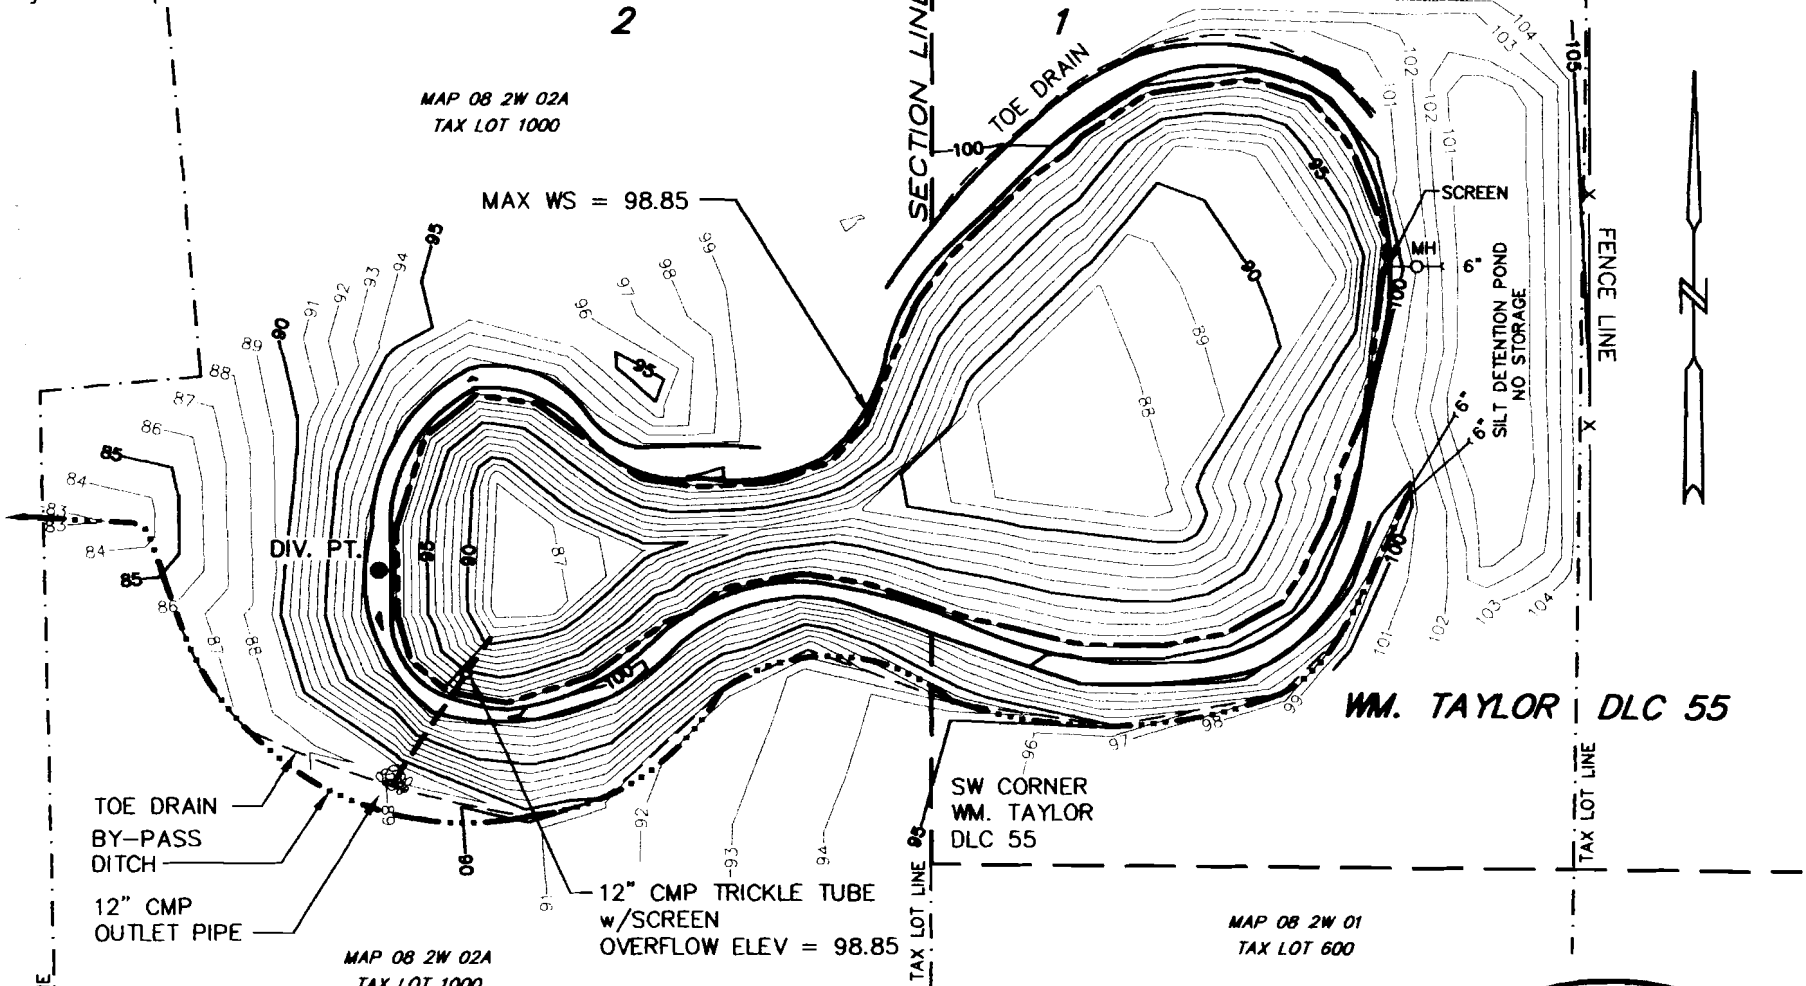

WM. TAYLOR DLC 55

SW CORNER
WM. TAYLOR
DLC 55

12" CMP TRICKLE TUBE
w/SCREEN
OVERFLOW ELEV = 98.85

TOE DRAIN
BY-PASS
DITCH
12" CMP
OUTLET PIPE

MAP 08 2W 02A
TAX LOT 1000

MAP 08 2W 01
TAX LOT 600

DIV. PT.: 155' NORTH AND
290' WEST OF SW CORNER
WM. TAYLOR DLC 55.


FINAL PROOF SURVEY

UNDER

Application No. R-84170 Permit No. R-12857

TIM BAUGHMAN & CAROL BAUGHMAN

OCTOBER 13, 2003
SCALE 1" = 100'

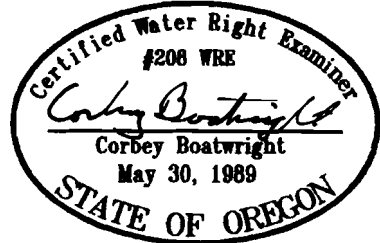

EXPIRES: 12-31-2005

TAX LOTS:
8 2W 01 00600
8 2W 02A 01000

RECEIVED