

WATER RESOURCES DEPT.  
SALIMA OREGON

OCT 27 1997

RECEIVED

This map is for the purpose of locating a water right only and has no intent to provide legal dimensions or the location of property lines.

6293 Sunnyview Rd. NE  
Salem, OR 97305  
Bend, OR 97702  
(503) 585-7593  
(503) 382-7391

**ESTES SURVEYS**




WILLIAM S. & PENNY RITCHIE


for  
Claim of Beneficial Use Map

App R-75034 Per R-11930  
App 5-75033 Per 52630

Surveyed August 23, 1994

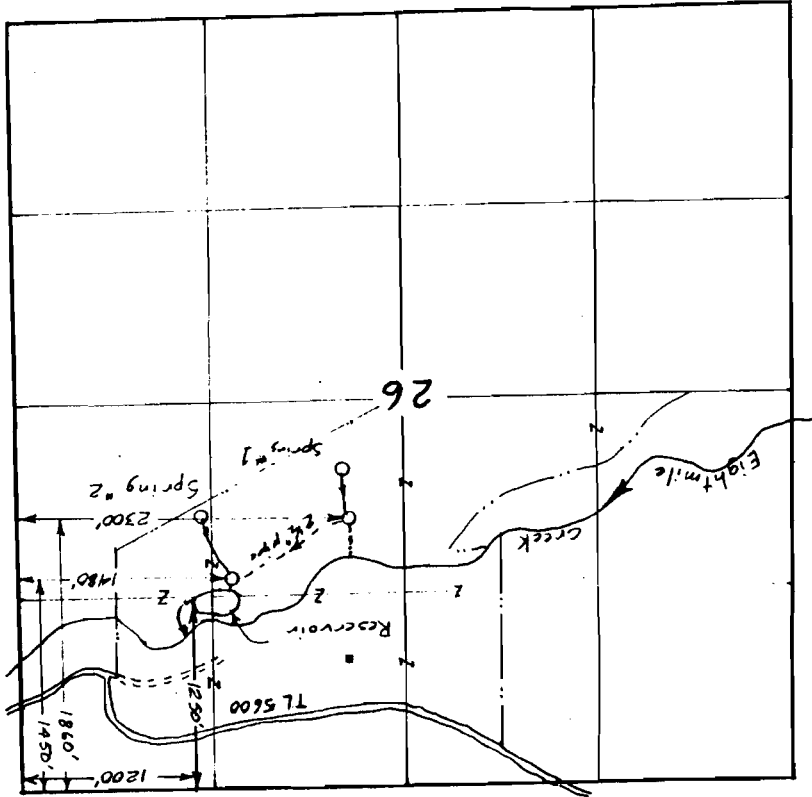

Scale 1" = 1320'

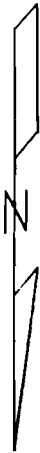

TOWNSHIP 1 SOUTH, RANGE 12 EAST, W.M.