

LEGEND



ADDITIONAL POD #6 REQUESTED
FOR C-7803, 1926, ORIG. IRRIG
VIA PODS 2, 4, & 5



WATER RIGHT C-7803, 1926
ORIG. IRRIGATED VIA PODS 1 & 3



WATER RIGHT C-82707, 1984
IRRIGATED WITH PIPELINE
FROM POD #6


--- GOOSEBERRY PIPELINE

POD LOCATIONS

- #1 785'E 3285'N OF 1/4 COR
- #2 545'E 820'N OF 1/4 COR
- #3 1560'E, 334'N OF SEC COR
- #4 645'E, 920'S OF 1/4 COR
- #5 875'E, 415'N OF SEC COR
- #6 1025'W, 1485'S OF SEC COR

- SEC 31-32
- SEC 31-32
- 31-32
- SEC 31-32
- 31-32
- 6-5


THE ADDITIONAL POD IS
REQUESTED FOR
 $8.0 + 8.7 + 18.0 + 1.6 = 36.3$ AC

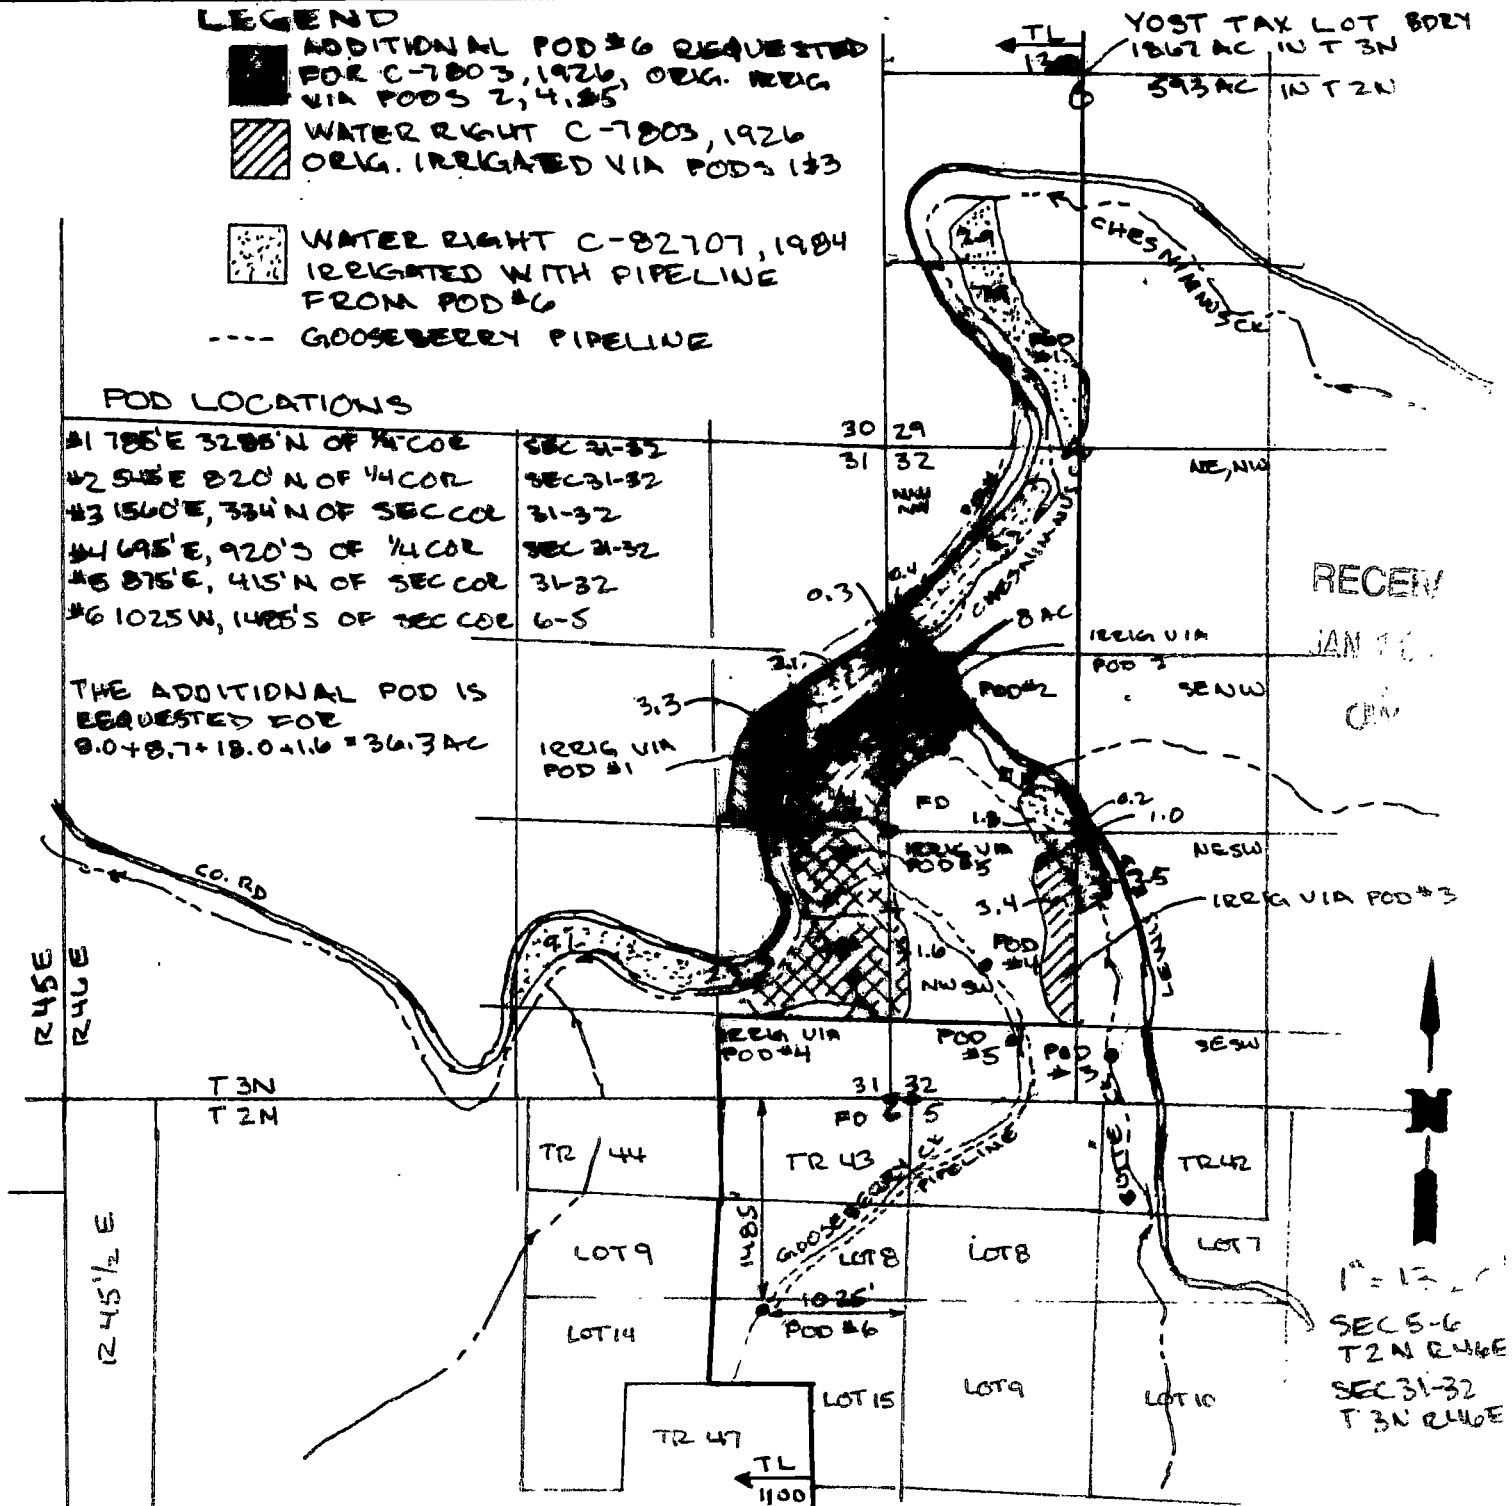

MAP SHOWING HISTORICAL POD'S 1-5 FOR C-7803 AND
REQUEST FOR ADDITIONAL POD #6 WHICH IS SAME POD AS
C-82707

ALL AREAS SHOWN ~~XX~~ HAVE BEEN
IRRIGATED VIA POD #6 BY OCT 1, 2023

THIS MAP IS PREPARED FOR WATER RIGHT PURPOSES
ONLY AND SHOULD NOT BE USED FOR PROPERTY
LOCATION PURPOSES

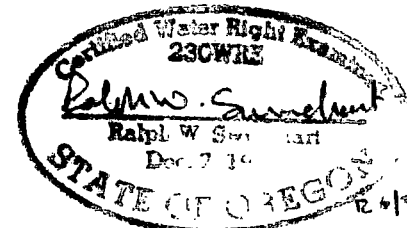

CLAIM OF BENEFICIAL USE MAP
FOR T-13547
ADDITIONAL POD FOR C-7803
WALLOWA COUNTY

OWNER:
COOL SPRINGS RANCH LLC
216 NEWBERG RD
CHADIN, SOUTH CAROLINA 20936
PREPARED BY: RALPH W. SWINEHART
ENTERPRISE, OREGON
OCTOBER 2023