
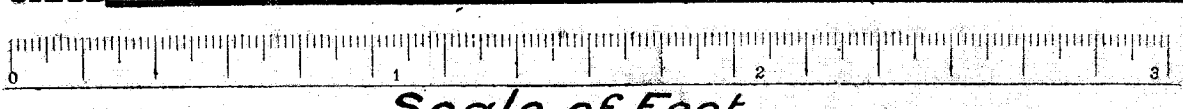


Township 39.5, Range 7 W. W. M.

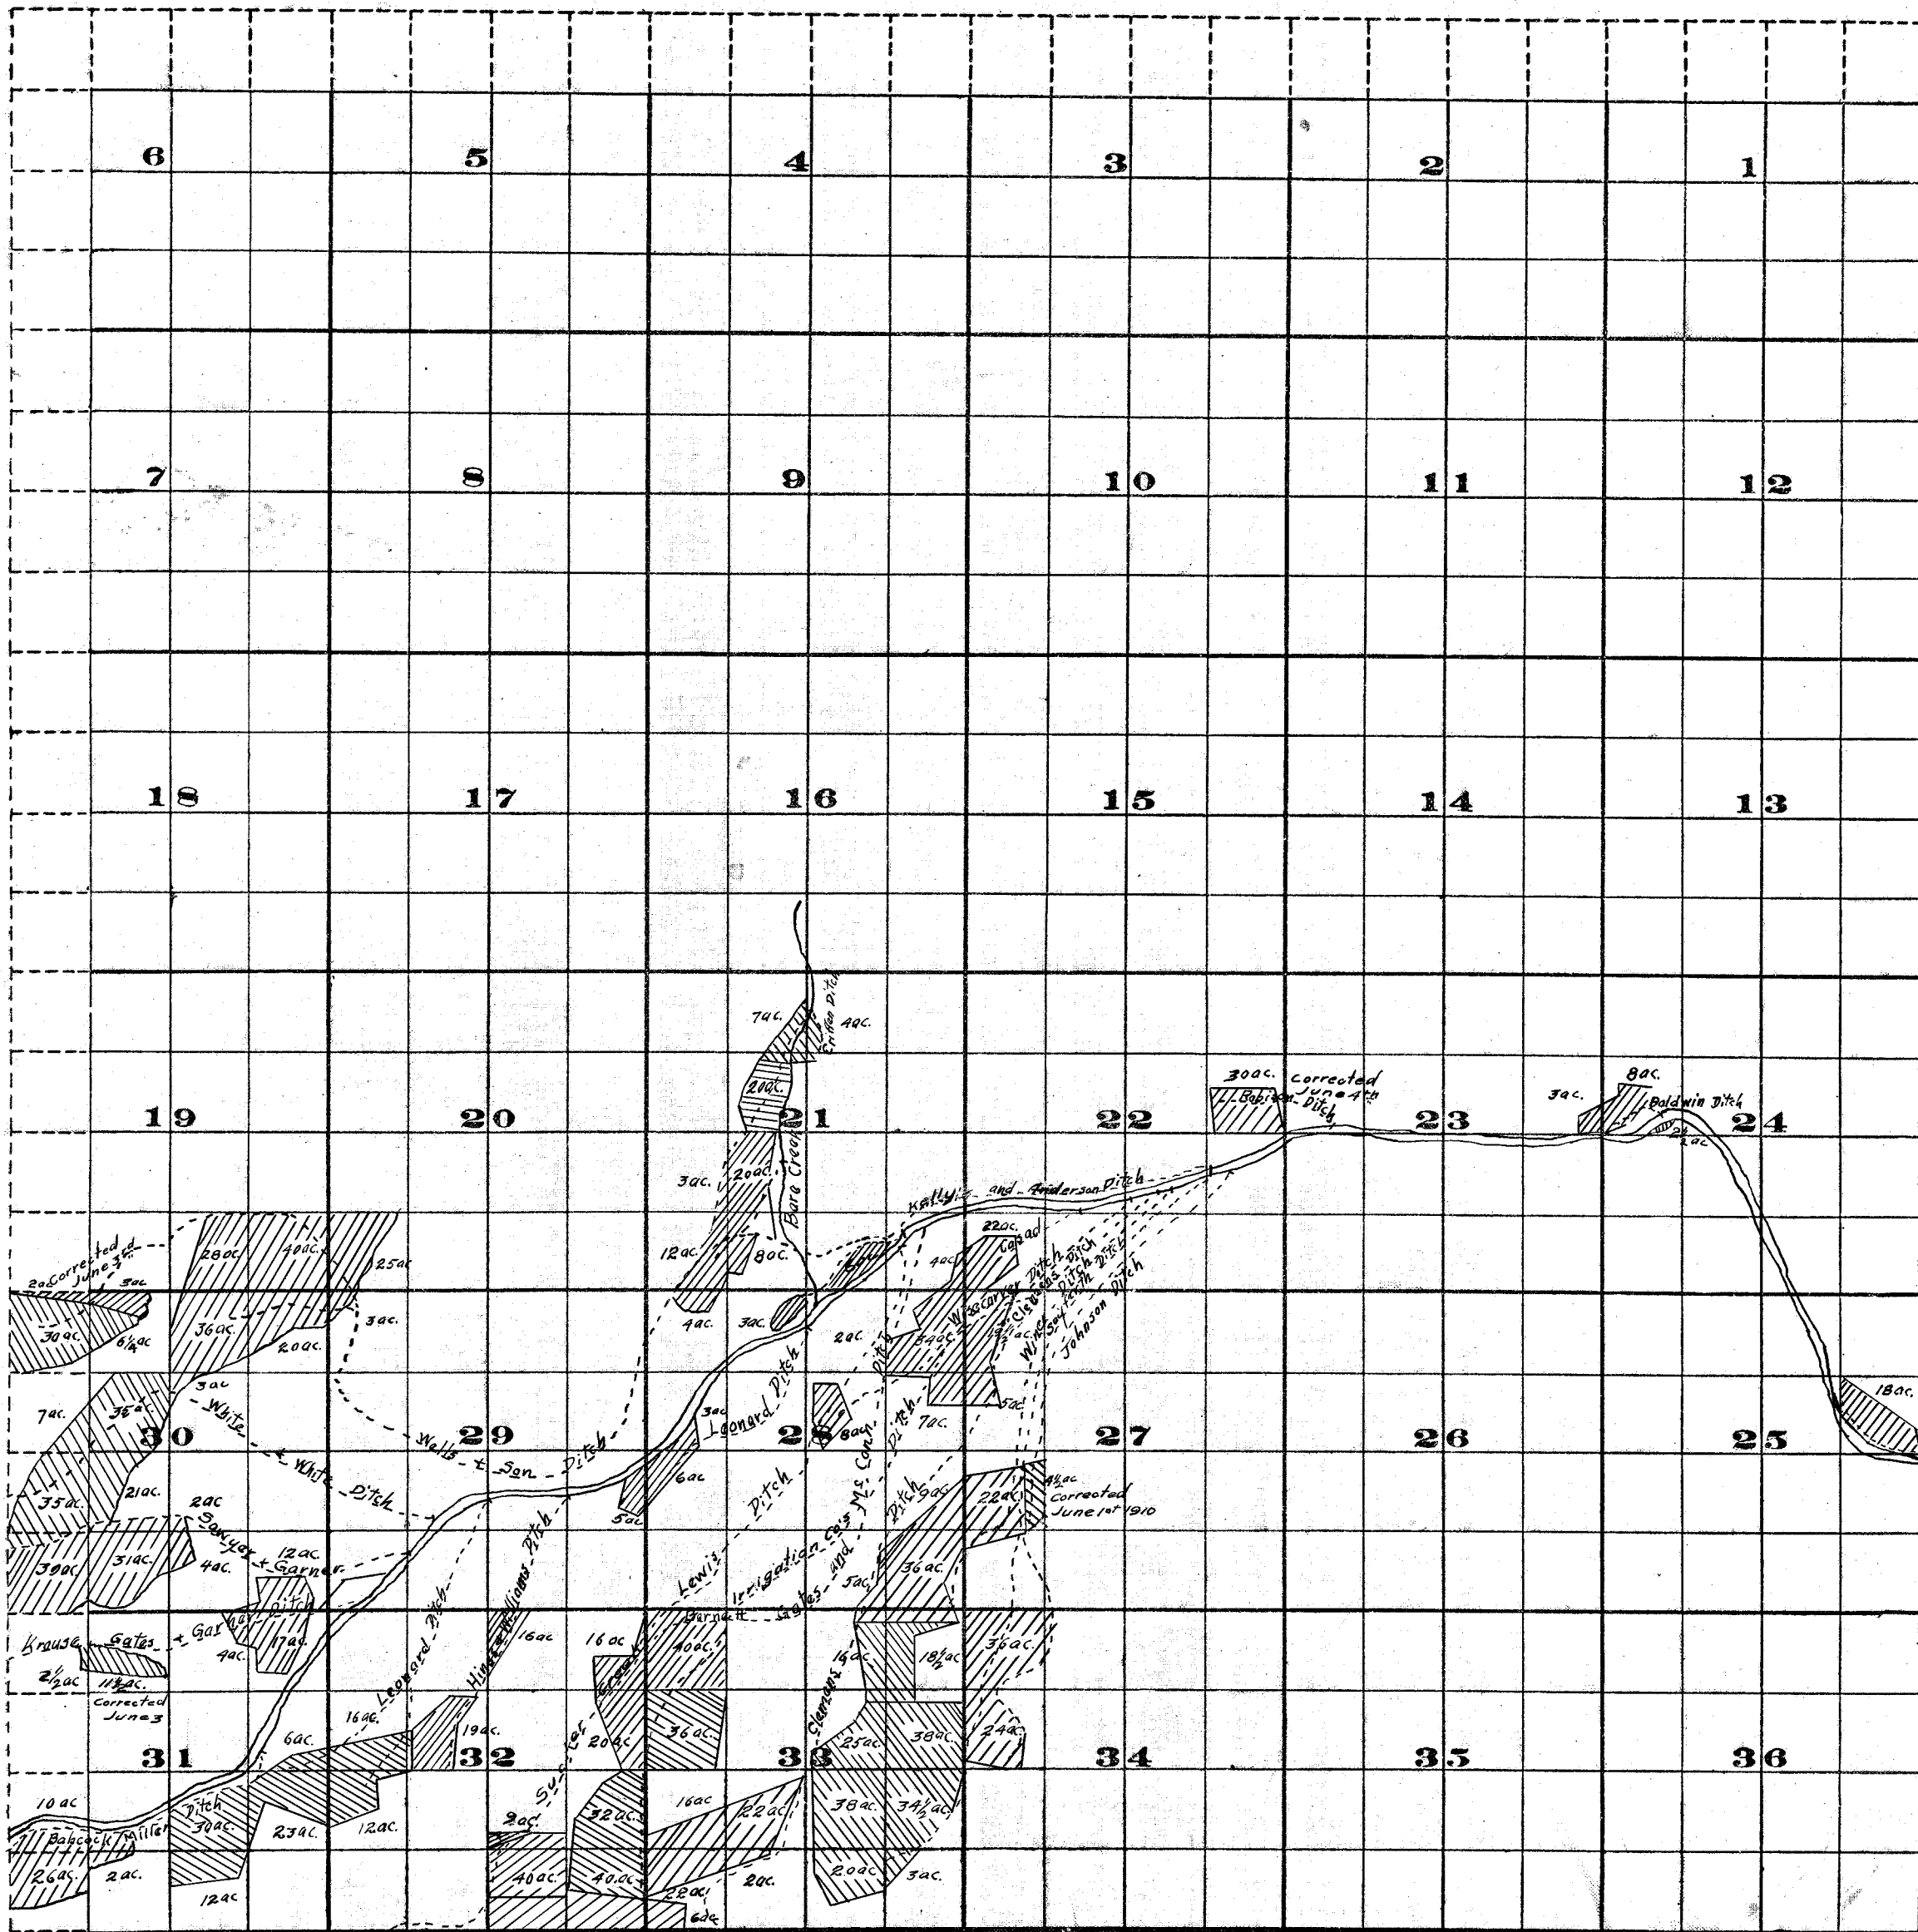

FROM OFFICE OF THE STATE ENGINEER, SALEM, OREGON

Survey by J.S. Mc Mahon,
 March 1910.
 J. H. Lewis, State Engineer.

Sucker Creek Adjudication

Examined June 15th 1910.