


TOWNSHIP 3 SOUTH, RANGE 4 WEST, W.M.
SECTION 10

RECEIVED

JUL - 9 1997

WATER RESOURCES DEPT.
SALEM OREGON

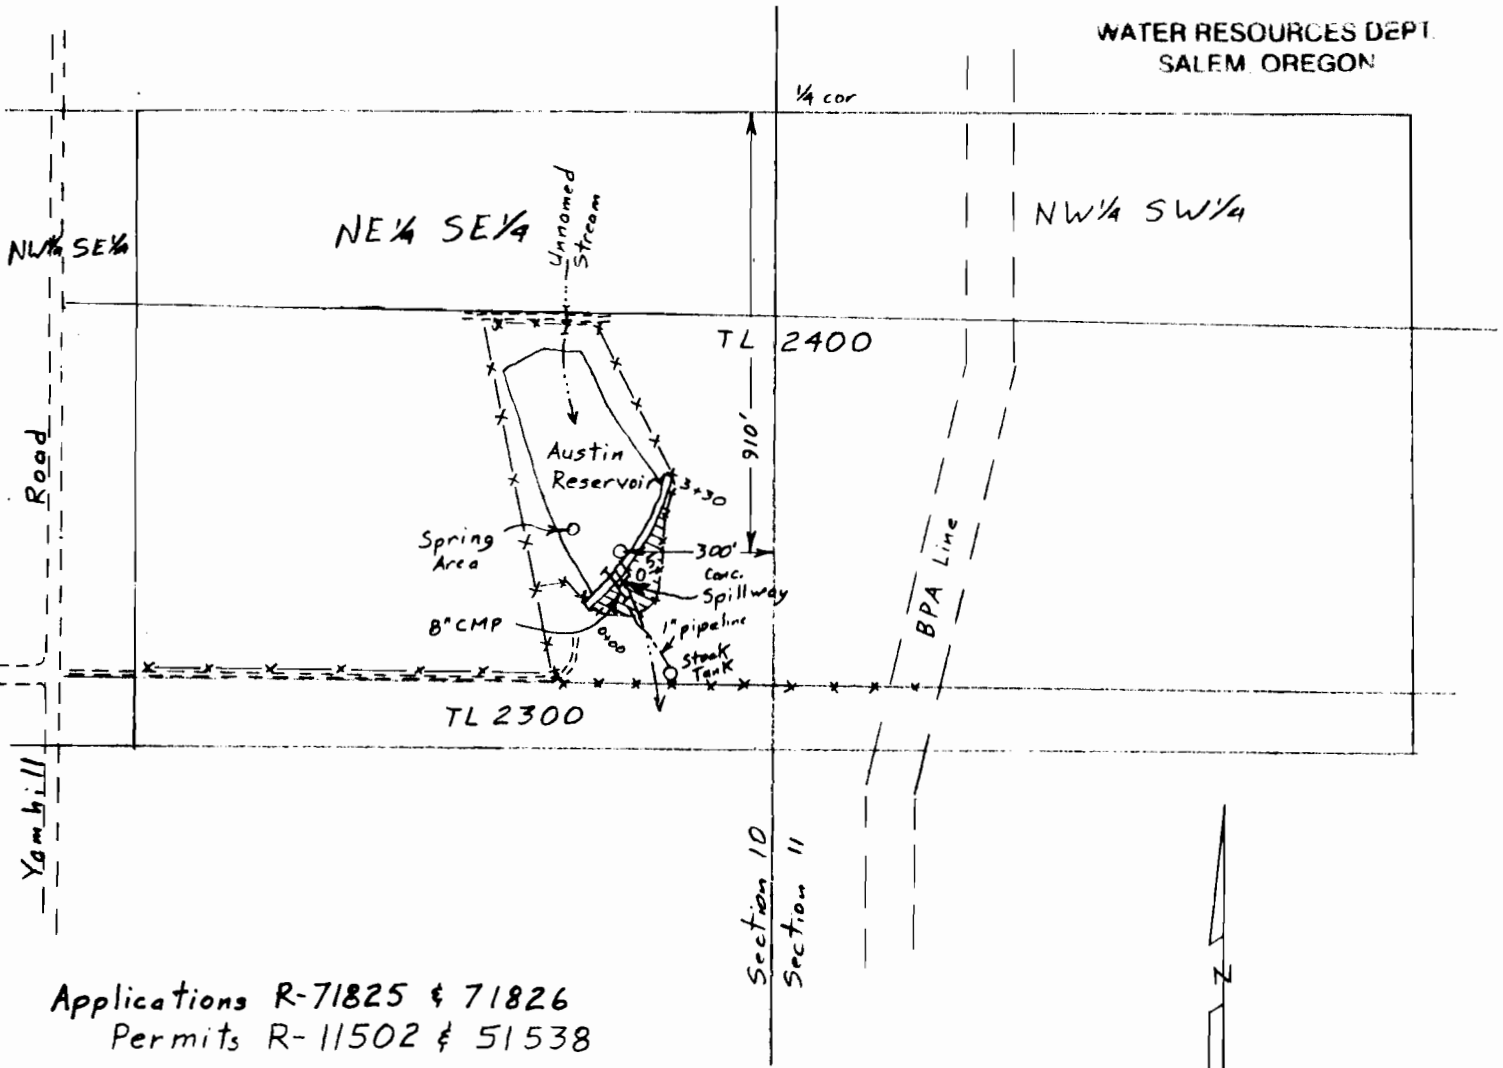


Applications R-71825 & 71826
Permits R-11502 & 51538

Surveyed May 24, 1997

Scale 1" = 400'

Claim of Beneficial Use Map
for
the Estate of
JOE G. AUSTIN

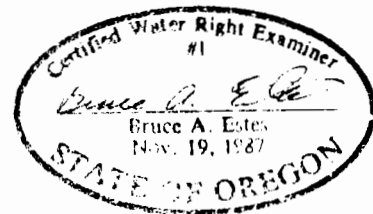

This map is for the purpose of
locating a water right only
and has no intent to provide
legal dimensions or the location
of property lines.

ESTES SURVEYS

6293 Sunnyview Rd NE 60382 Arnold Rd.
Salem, OR 97305 Bend, OR 97702
(503) 585-7593 (503) 382-7391