

Request for Assignment

RECEIVED

DEC - 9 2022

OWRD

OREGON



Oregon Water Resources Department
725 Summer Street NE, Suite A
Salem, Oregon 97301-1266
(503) 986-0900
www.oregon.gov/owrd

If the Department determines that the application is incomplete, fees have not been paid, or the required documents are not acceptable, the application and all fees submitted will be returned to the applicant.

If for multiple rights, a separate form and fee for each right will be required.

I, SANDY FARMS, LLC

(Name of Current Holder of Record)

34500 SE HIGHWAY 211 BORING OR 97009

(Mailing Address)

(City) (State) (Zip) (Phone #)

hereby assign all my interest in and to the entire application/permit/transfer order/limited license/groundwater statement; (example, sold all the land authorized under the right)

hereby assign all my interest in and to a portion of application/permit/transfer order/limited license/groundwater statement; (You must include a map showing the portion of the application/permit/transfer order/limited license/groundwater statement to be assigned. Example, sold a portion of the land authorized under the right) (THE PORTION PREVIOUSLY ASSIGNED TO SANDY FARMS)

hereby assign a portion of my interest in and to the entire application/permit/transfer order/limited license/groundwater statement; (example, adding an additional person)

Application # _____; Permit # _____; Transfer Order # _____;

Limited License # _____; Groundwater Statement # GR-3536;

as filed in the office of the Water Resources Director, to:

PATTERSON NURSERY SALES, INC

(Name of New Owner)

P.O. Box 68

EAGLE CREEK, OR 97022 (503) 519-2902

(Mailing Address)

(City) (State) (Zip) (Phone #)

Note: If there are other owners of the property described in the application, permit, transfer order, limited license, or groundwater statement, you must provide a list of all other owners' names and mailing addresses and attach it to this form. Write the initials (first letters) of your first and last names at the spot indicated below.

DP I hereby certify that I have notified all other owners of the property described in this application, permit, transfer order, limited license, or groundwater statement of this Request of Assignment.

X Witness my hand this 30th day of NOV, 2022
(Day) (Month) (Year)

Signature of Current Holder of Record X DP P Miller - Sandy Farms, LLC

Failure to provide any of the required information will result in the return of your application.

This certifies assignment and record change at Oregon Water Resources Department effective 8:00 a.m. on date of receipt at Salem, Oregon.

Fee receipt # 139712

For Director by Mary F. Bjork, Program Analyst in Water Rights Division. MFB

The completed "Request for Assignment" form *must* be submitted to the Department along with the recording fee of \$120.

Part Assign - Approve
MFB 12-13-2023

T.2S., R.4E., W.M.

RECEIVED

SEP 07 2021

OWRD

THIS MAP IS FOR THE PURPOSE OF IDENTIFYING THE LOCATION OF THE WATER RIGHT ONLY AND IS NOT INTENDED TO PROVIDE LEGAL DIMENSIONS OR LOCATIONS OF PROPERTY OWNERSHIP LINES.

Sections 29 | 28

SECTION 29
SE 1/4 NE 1/4

SECTION 28
SW 1/4 NW 1/4



Expires:

RECEIVED


DEC 12 2023

OWRD



SCALE: 1" = 400'

Proposed Adjt'l PUA

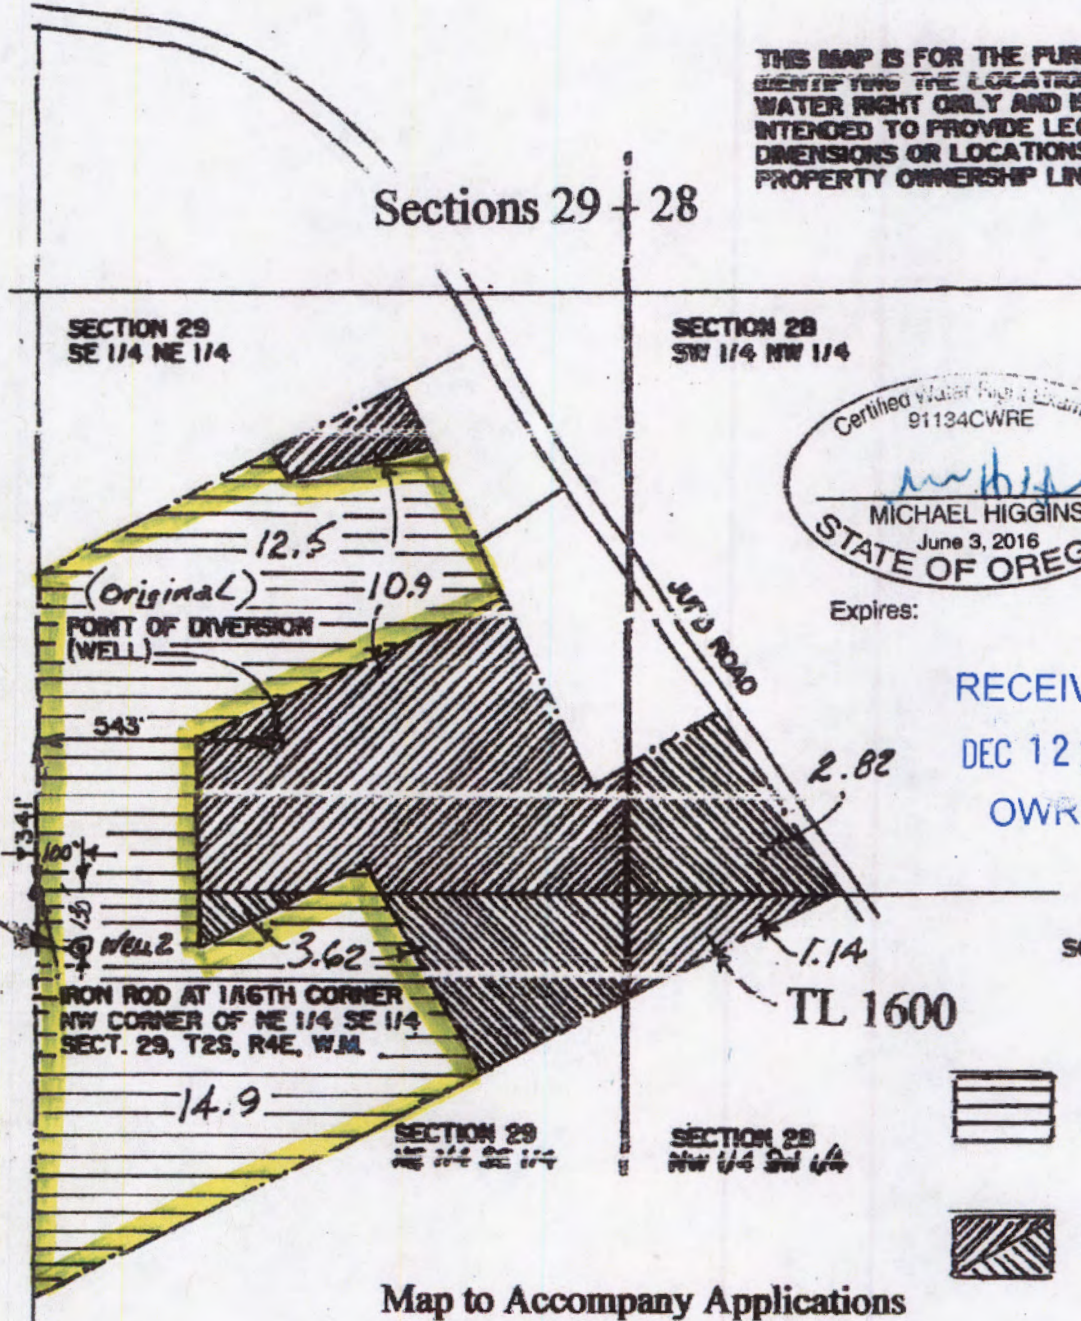

GR Cert. 3536 -
27.4 acres



Certificate 67733 -
18.48 acres

Map to Accompany Applications
For Additional PUA Under
Certificate #GR-3536 & Certificate 67733,
In the Name of Patterson Nursery Sales, Inc.

RECEIVED

DEC 28 2022

OWRD

14136