


Township 6 South, Range 4 West, W.M.

NE 1/4 NE 1/4, Section 22

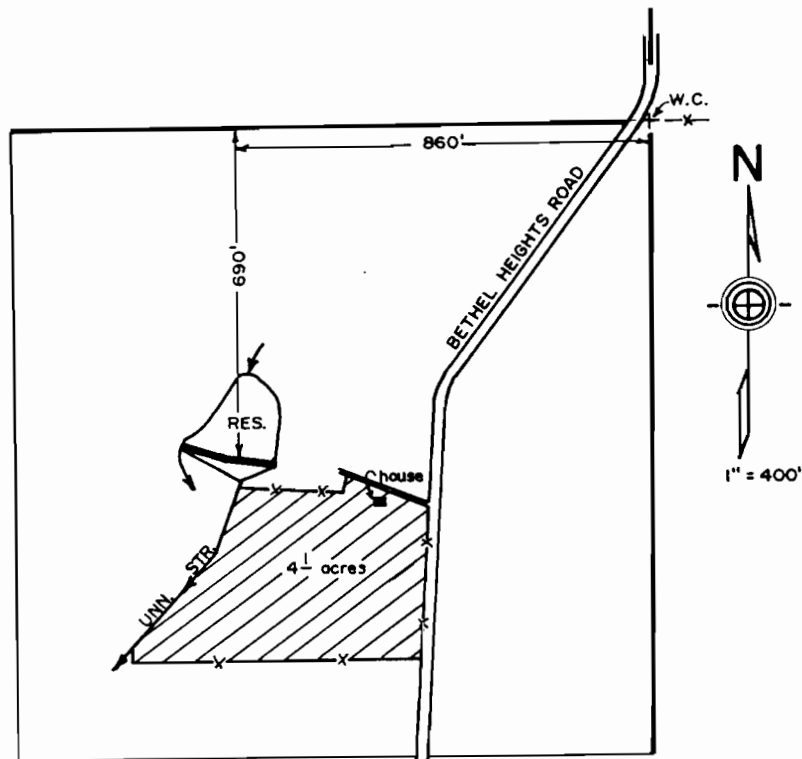

FINAL PROOF SURVEY

under

Appl's. No R-71811, Per's.No. R-11458

71812

51461

in name of


VEDAN STOLK

Feb. 23, 1996

RECEIVED

MAR - 7 1996

WATER RESOURCES DEPT.
SALEM, OREGON

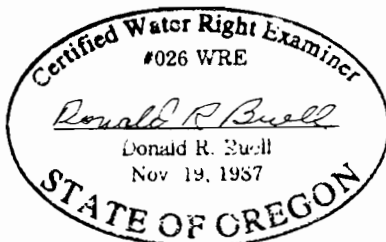

THIS MAP WAS PREPARED FOR THE PURPOSE OF IDENTIFYING THE LOCATION OF A WATER RIGHT ONLY AND IS NOT INTENDED TO PROVIDE LEGAL DIMENSIONS OR LOCATION OF PROPERTY OWNERSHIP LINES.