


Application No. 47829
Permit No. 35852

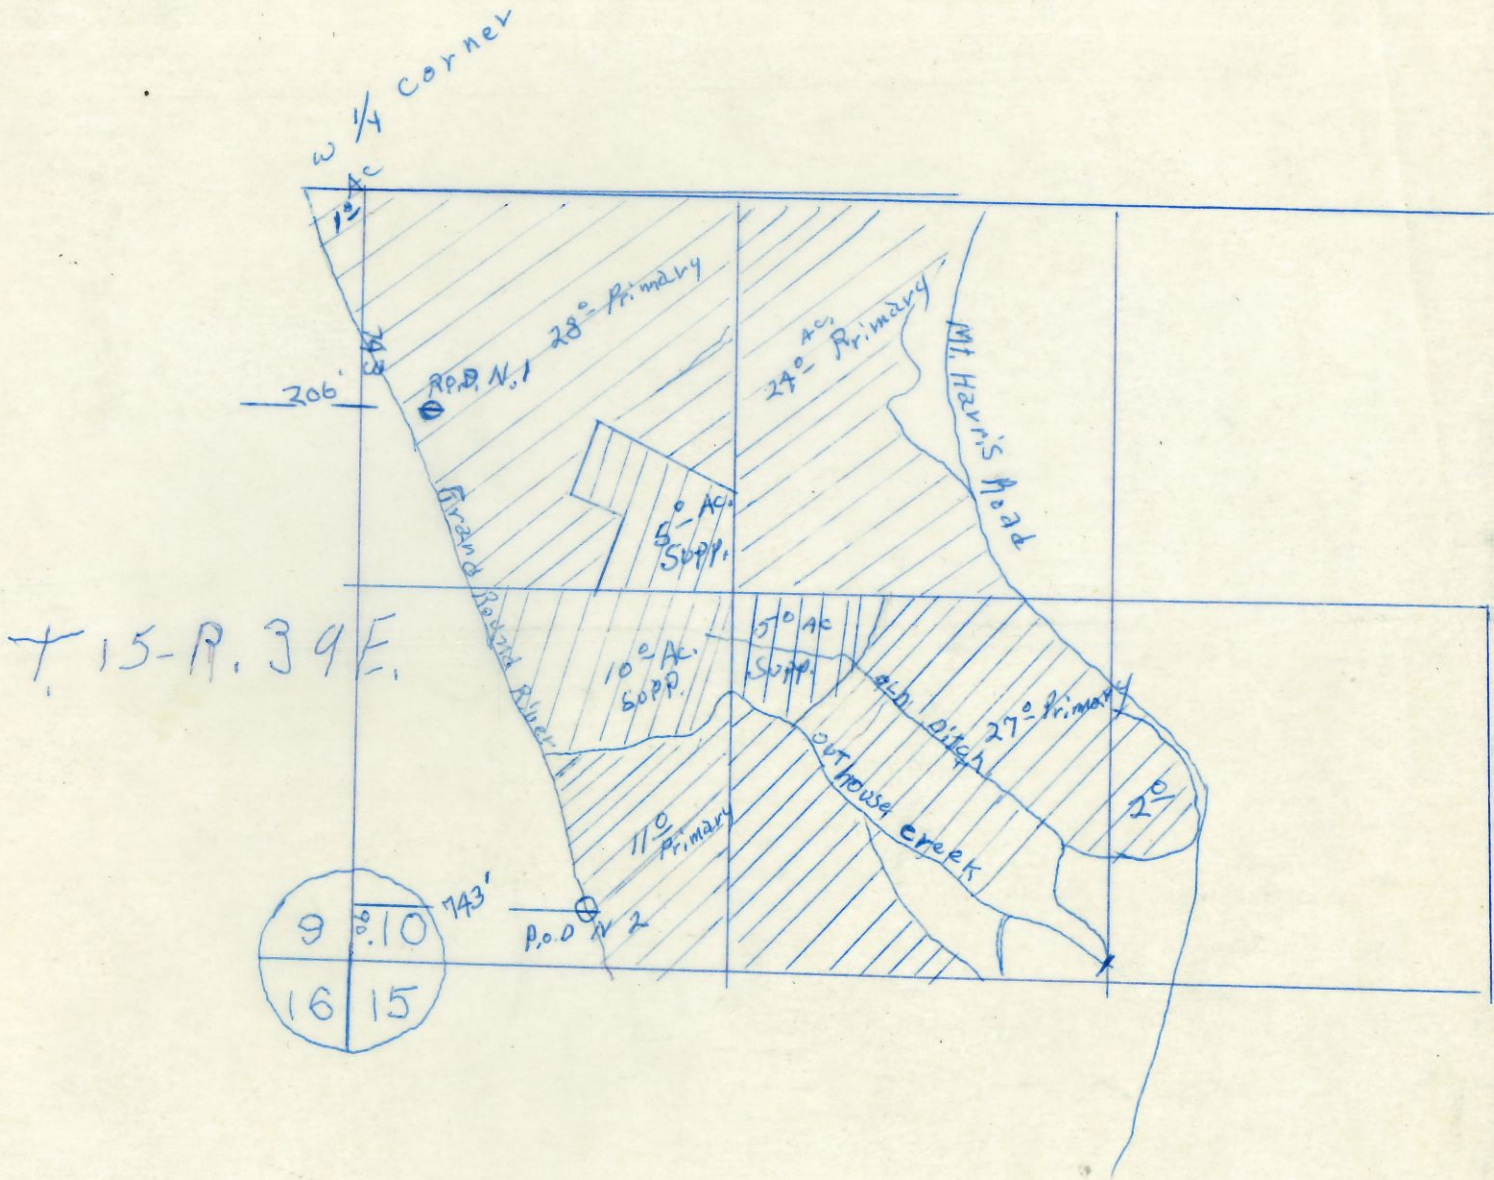

T 15-R. 39E.

RECEIVED
JAN 4 1970
STATE ENGINEER
SALEM, OREGON