


T-3296
3297

T.9S.R.5W.W.M.

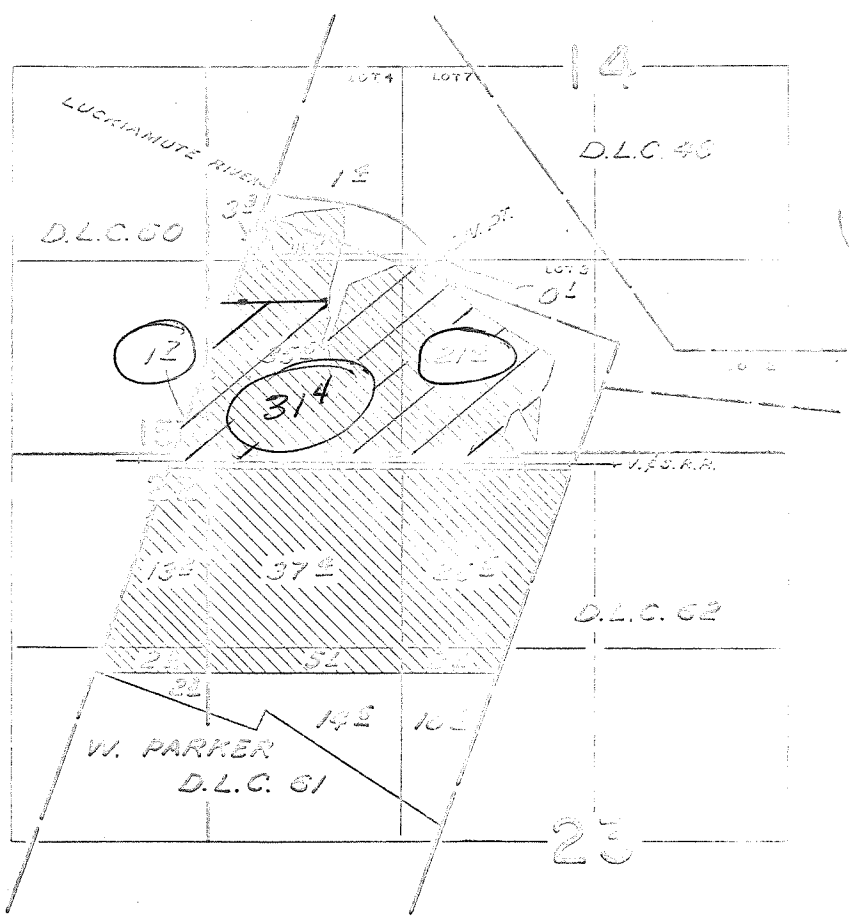


FINAL PROOF SURVEY
UNDER

Application No. 27635 File No. 27618
IN NAME OF

Stephen Benedict

Surveyed Aug. 4, 1965, by C. GARDNER

9S 5W

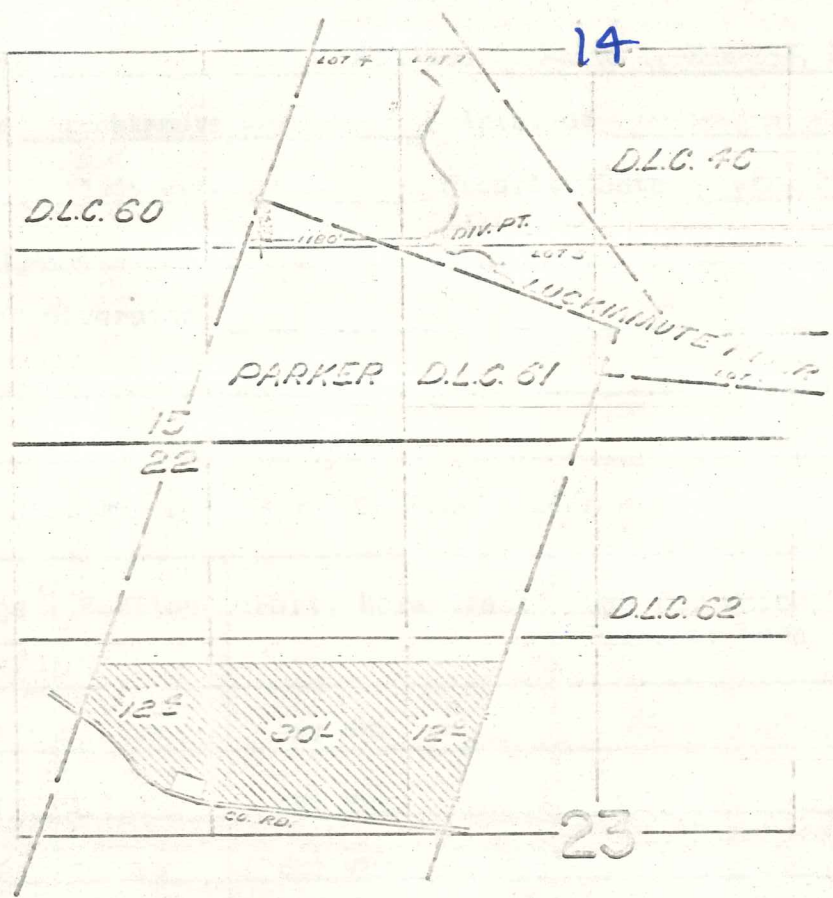

FINAL PROOF SURVEY
UNDER

Application No. 41793 Permit No. 31207
IN NAME OF

STEPHEN BENEDICT

Surveyed MAR. 25 1969 by D.R. DUGAN