


Township 39.5, Range 8.W.W.M.

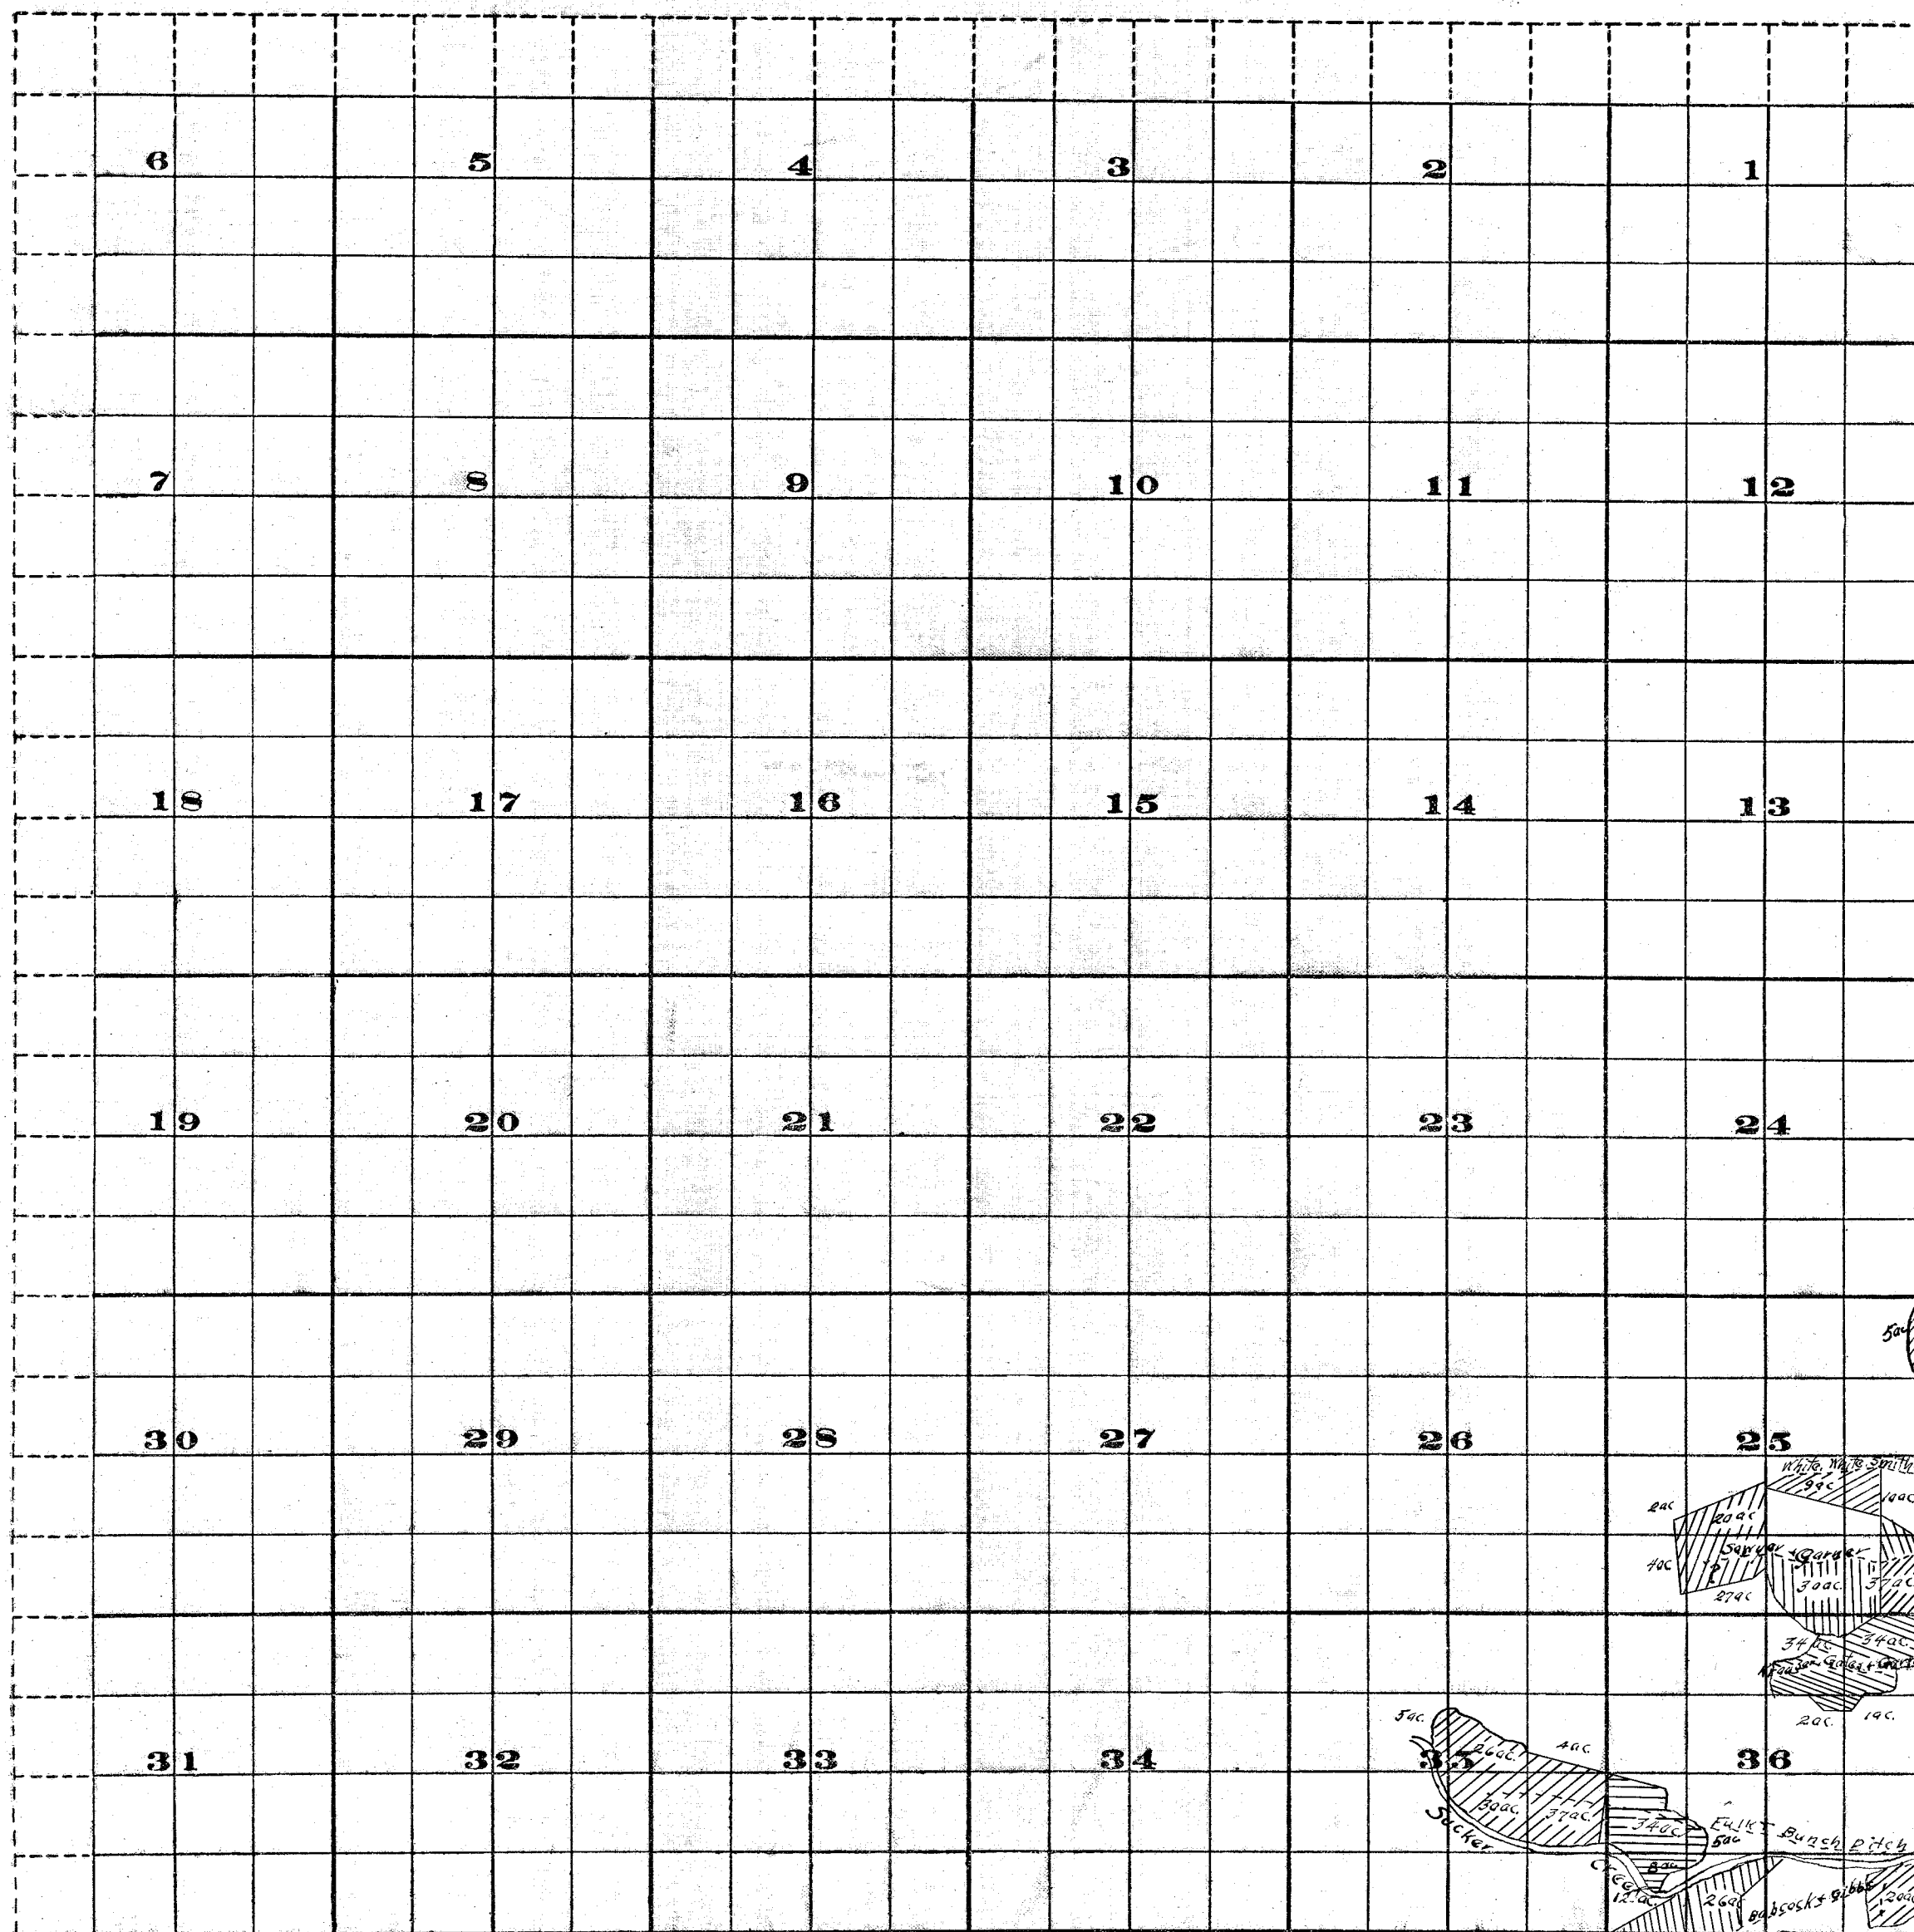

FROM OFFICE OF THE STATE ENGINEER, SALEM, OREGON

Survey by J.S. McManan
March 1910.

CK. by D.F.M. 9/15-11
" " " 3/16-12 J.H. Lewis State Engineer

Examined June 1st 1910.

Sucker Creek Adjudication