

SECTION 21, T3N R3W WM

WASHINGTON COUNTY, OREGON


RECEIVED

WATER RESOURCES DEPT.
AUG 29 1995
SALEM, OREGON




SCALE: 1" = 400'

MAP BASE:
COUNTY
ASSESSORS
MAP & WAC
1994 PHOTO

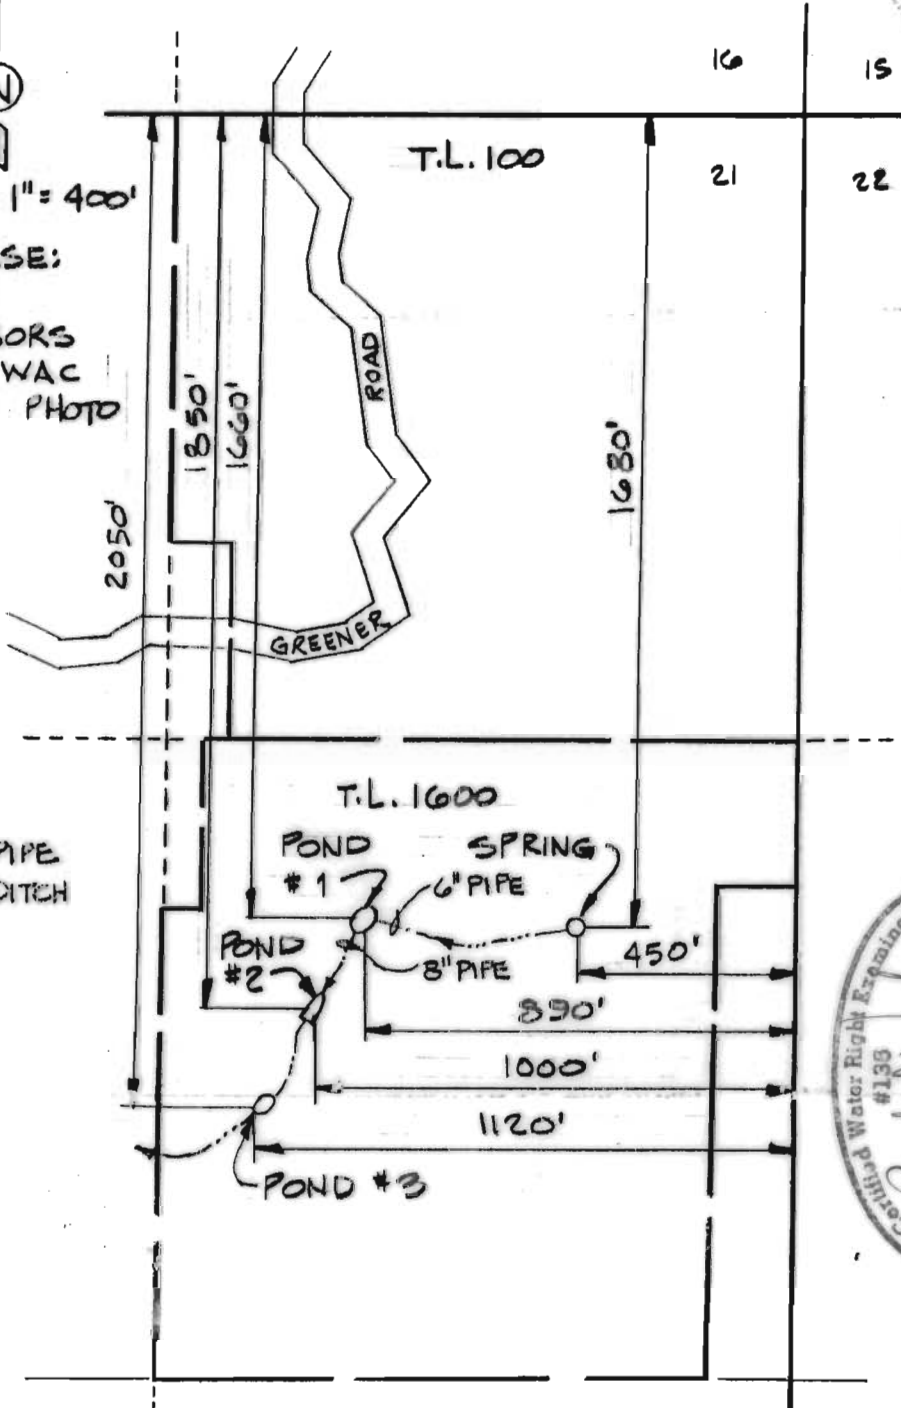

PREPARATION OF THIS MAP IS FOR THE
PURPOSE OF IDENTIFYING THE LOCATION OF
THE WATER RIGHT ONLY. THERE IS NO INTENT
TO PROVIDE DIMENSIONS OR LOCATION OF
PROPERTY OWNERSHIP LINES.

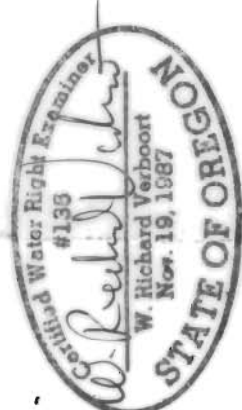

FINAL PROOF SURVEY

UNDER

APPLICATION R-71192 PERMIT R-11464

SURVEYED AUGUST 21, 1995

VERBOORT ENGINEERING
AGRICULTURE • CIVIL • WATER RESOURCES
HILLSBORO, OREGON

by date
designed WRV 8.95
drawn JER 8.95
checked WRV 8.95
drawing no. 95-A-08
sheet no. 1/1

DAVID & MARY STOCKER
29600 NW GREENER RD
CORNELIUS, OR 97113