

Alternate Reservoir Application Map
Glasscock
T.25S. R.6W. Section 8
Douglas County




Scale: 1" = 800'

RECEIVED

JAN 26 2023

OWRD

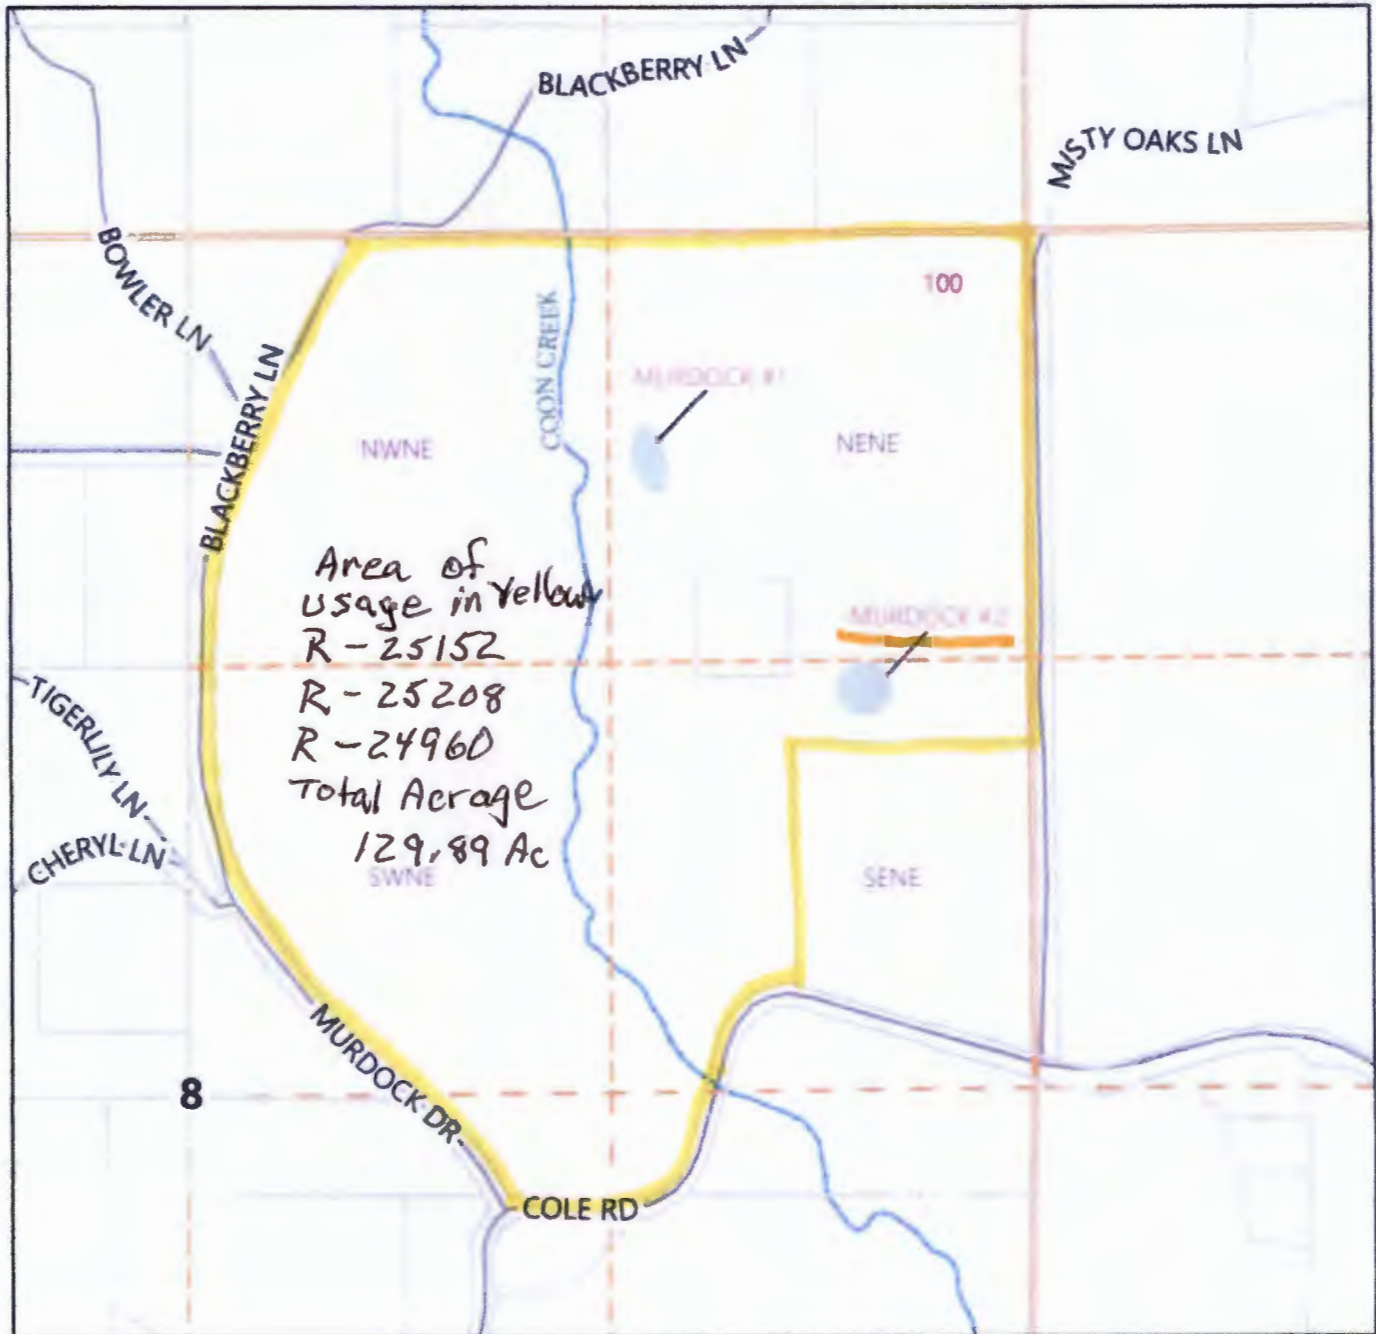

MURDOCK # 1 is 972 ft. South and 1625 ft. West from the NE Section Corner 8

MURDOCK # 2 is 1950 ft. South and 709 ft. West from the NE Section Corner 8

The purpose of this map is to identify
the location of a Water Right.
Not intended to show property ownership.

RECEIVED

FEB 02 2024

OWRD