

Request for Assignment By Proof of Ownership (If Water Right Holder is Not Available)



Oregon Water Resources Department
725 Summer Street NE, Suite A
Salem, Oregon 97301-1266
(503) 986-0900
www.oregon.gov/owrd

If the Department determines that the application is incomplete, fees have not been paid, or the required documents are not acceptable, the application and all fees submitted will be returned to the applicant.

If for multiple rights, a separate form and fee for each right will be required.

I, Perry Family Trust

(Name of Party Requesting Assignment)

40814 Sandpiper Ct.

Palm Desert CA 92260

(760) 568-0681

(Mailing Address)

(City)

(State)

(Zip)

(Phone #)

- hereby request assignment of an entire application/permit/transfer order /limited license/groundwater statement;
- hereby request assignment of a portion of application/permit/transfer order/limited license/groundwater statement; (You must include a map showing the portion of the application/permit/ transfer order /limited license/groundwater statement to be assigned.)

Application # _____; Permit # _____; Transfer Order # _____;

Limited License # _____; Groundwater Statement # GR 288 _____;

Nick J. Nelke

(Name of Current Holder of Record)

Rt. 1, Box 732

Salem OR

(Mailing Address)

(City)

(State)

(Zip)

(Phone #)

Note: Write the initials (first letters) of your first and last names at the spots indicated below _____.

- JN I certify that I am the current owner of the property described in this application, permit, transfer order, limited license, or groundwater statement. I have attached proof of ownership that may include but not be limited to: a copy of the deed to the land, a copy of a land sales contract, a court order or decree, documentation of survivorship of property held jointly. The Department cannot accept a copy of a tax statement.
- JN I have the legal right to request assignment under OAR 690-310-0280 and 690-320-0060.
- JN I have not been able to contact the owner(s) of record for the above referenced transaction. I have attached proof acceptable to the Department that notice of the assignment has been given or attempted for each identified property owner not a party to the assignment. ORS 537.220(2) Failure to submit this proof will result in the return of your request. (Proof may include but not be limited to: a copy of returned certified mailing, copy of a Death Certificate, or a court order.)
- JN I further certify that the information provided herein is true and correct to the best of my knowledge.

Witness my hand this 26th day of Dec, 2023.
(Day) (Month) (Year)

Signature of Party Requesting Assignment John Nelke

Failure to provide any of the required information will result in the return of your application.

This certifies assignment and record change at Oregon Water Resources Department effective 8:00 a.m. on date of receipt at Salem, Oregon.

Fee receipt # 142196

For Director by Mary F. Bjork, Program Analyst in Water Rights Division. MFB

The completed "Request for Assignment" form must be submitted to the Department along with the recording fee of **\$120**.

Part Assign by Proof - Approve
WSD
1-29-2024

RECEIVED

JAN ^{WR} 4 2024


OWRD

Received by OWRD

JAN 29 2024

Salem, OR

Township 6 S Range 3 W, W.M.
North

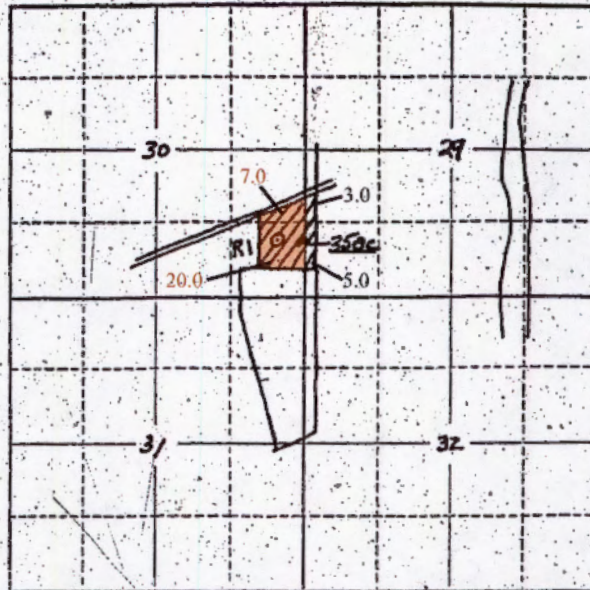

Locate well and acreage of irrigated land on plat.

Scale: 2" = 1 Mile

STATE OF OREGON

County of Marion } ss.

I, Nick J. Neelke being first duly sworn, do hereby certify that I have read the foregoing Registration Statement and that all of the items therein contained are true to the best of my knowledge and belief.

Nick J. Neelke
(Signature of Registrant)

Subscribed and sworn to before me this 1st day of November, 1956.

My commission expires 9/27/58
Jeanie Baxter
(Notary Public)

(SEAL)

CERTIFICATE OF REGISTRATION

STATE OF OREGON

County of Marion } ss.

This is to certify that the foregoing Registration Statement was received in the office of the State Engineer on the 5th day of November, 1956, at 8 o'clock A.M. and has been duly recorded in said office in Book No. 2 of Registration Statements on page GR-261-C


Witness my hand this 15th day of January, 1957.
Lewis A. Stanley
(State Engineer)

By _____ (Deputy)
GR-261 C