


T. 29 S. R. 14 W. W.M.

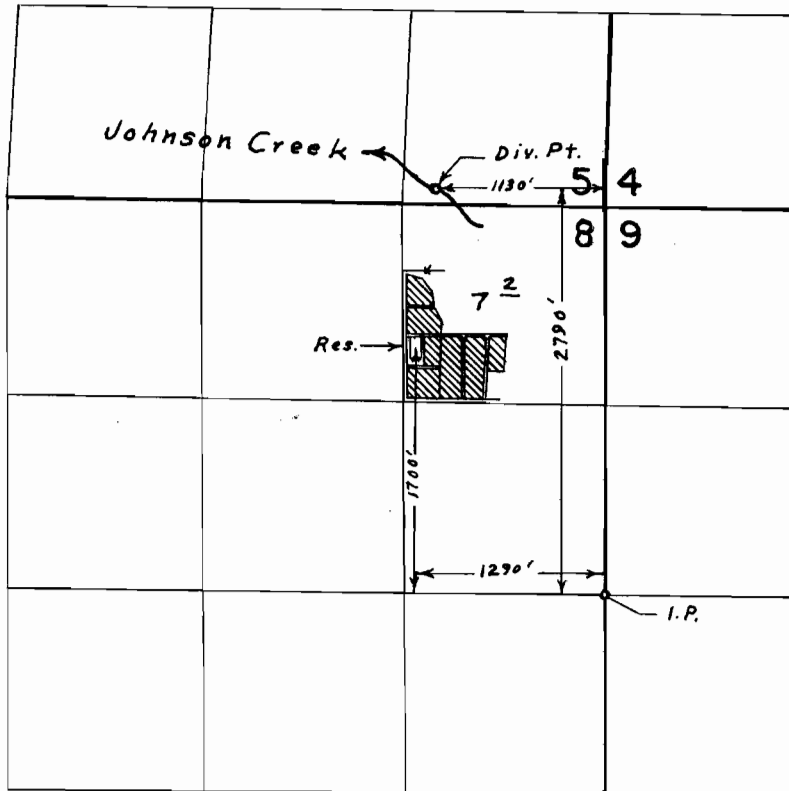

FINAL PROOF SURVEY UNDER

R-43303 R-4979
Application No. 43304 Permit No. 32435 **R11608**
IN NAME OF

ROBERT H. STOLZ

Surveyed April 17, 1972., by L. E. Gould.