
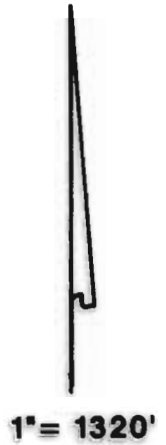


T.6S., R.6&7W., W.M.


RECEIVED

SEP 19 1995

WATER RESOURCES DEPT.
SALEM, OREGON

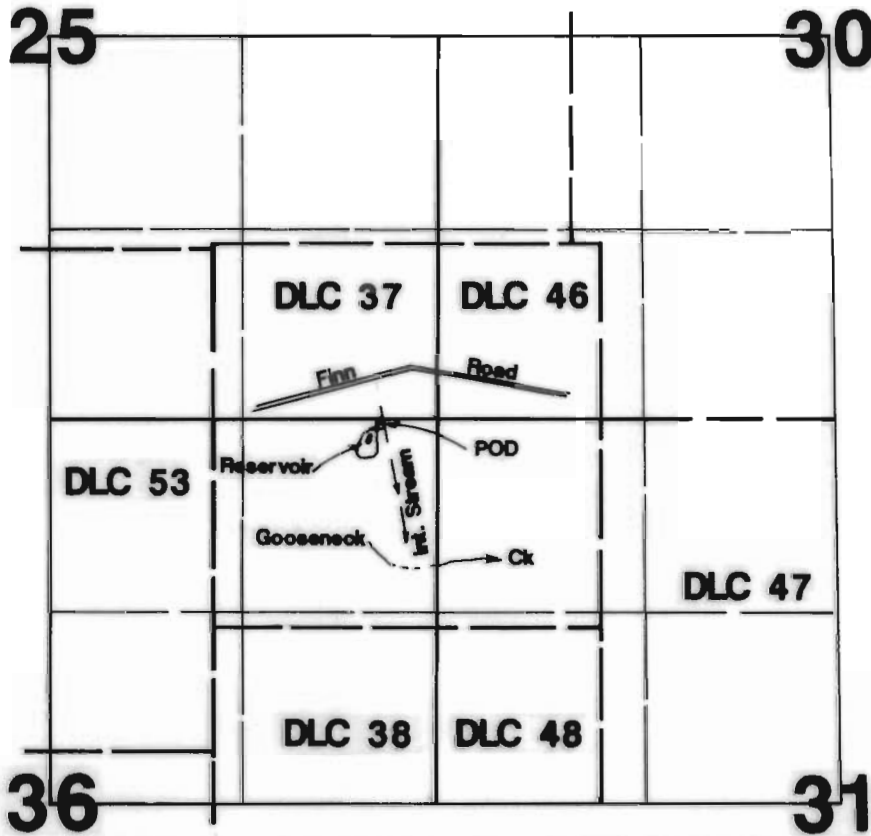

POD located 50'S & 400'W from NE corner Section 36.

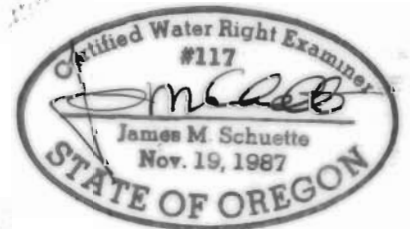

Final Proof Survey

Application #: R-71746 Permit #: R-11405

In Name Of

Walton & Esther James

Surveyed on August 26, 1995 by JM Schuette