
## RECEIVED

## Township 5 South, Range I West, W.M.

Portions of Sections 23 & 24

DEC 2 0 19 9

WATER ESOURCES DEFE SALEM, OREGON

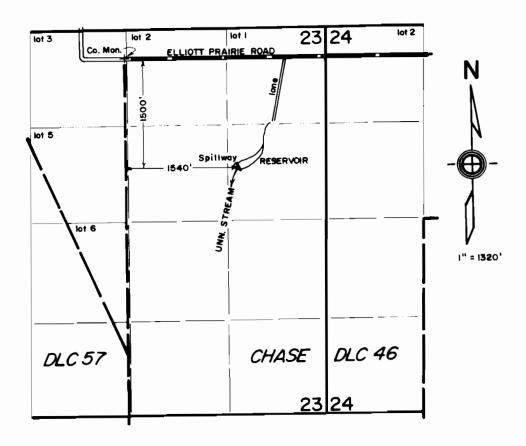

FINAL PROOF SURVEY
under
Appl. No. R-71712, Per. No. R-11610
in name of

MARVIN L. AND CHRISTINE B. RUFFING

Nov. 24, 1999

