


Received by OWRD

FEB 13 2024

Salem, OR

### Marion County

Township 3 South, Range 2 West from the Willamette Meridian  
Township 4 South, Range 2 West from the Willamette Meridian

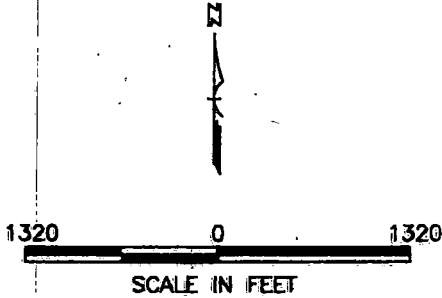

#### Map Legend


- - - - - Quarter/Quarter Section Line
- - - - - Half Section Line
- - - - - Section Line
- - - - - Tax/Lot Boundary Line
- - - - - DLC Boundary Line
- - - - - Buried PVC Water Supply Pipeline
- Primary Acres Irrigated from Well #4 (APOA)
- Supplemental Irrigated Acres

### CLAIM OF BENEFICIAL USE MAP

FOR  
Transfer Application T-13201  
in the name of

## Hazenberg Dairy

Well #4 (APOA) is 170 Feet South and 870 Feet East from the Northwest corner of Section 9, Township 4 South, Range 2 West from the Willamette Meridian.

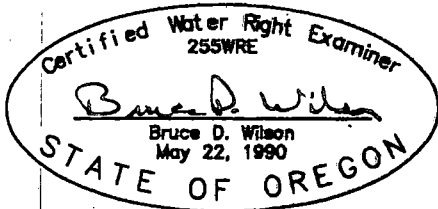

Expires: 06/30/2024

NOTE: THIS MAP WAS PREPARED FOR THE PURPOSE OF IDENTIFYING THE LOCATION OF A WATER RIGHT ONLY AND IS NOT INTENDED TO PROVIDE LEGAL DIMENSIONS OR LOCATION OF PROPERTY OWNERSHIP LINES.

