

FINAL PROOF SURVEY

APPLICATION S-71715 R-71704
 PERMIT 52421 R-11849
 SCALE 1" = 200 FEET



SE1/4 SE1/4 SE1/4

SW1/4 SW1/4 SW1/4

POD 1
 NORTH 68 FEET
 WEST 165 FEET
 OF SEC. CORNER

POD 2
 SOUTH 120 FEET
 EAST 380 FEET
 OF SEC. CORNER

TOTAL ACRES
 8.93

FIELD 2
 1.86 AC.

0.83 AC.

FIELD 3
 1.42 AC.

0.65 AC.

WOLF CREEK

POND SURFACE
 AREA 0.15 AC.

T29S R13W
 T30S R13W

LEGEND

● POD - POINT OF DIVERSION
 PH - PUMP HOUSE

○ FOUND SECTION CORNER

▣ 3/4" LINE INCIDENTAL WATER USE

▨ PLANTED FIELDS

ROAD DAM 3" GATE VALVE

— WATER LINE

FIELD 4
 0.75 AC.

GARAGE

GREEN HOUSE
 0.14 AC.

FIELD 5
 0.87 AC.


0.07 AC.

NE1/4 NE1/4 NE1/4

1.24 AC.

NW1/4 NW1/4 NW1/4

CATCHING CREEK

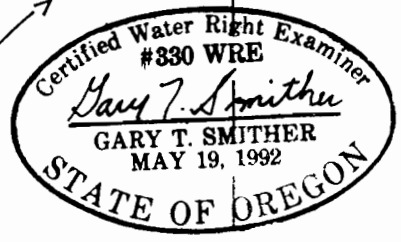

PREPARED FOR
 MOORE MILL CO.
 P.O. BOX 277
 BANDON, OREGON 97411



GARY T. SMITHER
OREGON SURVEYOR

P.O. BOX 545, NORTH BEND, OREGON 97459
 FAX & PHONE: (541) 751-9624

NOTE: THE PREPARATION OF THIS MAP IS FOR THE PURPOSE OF IDENTIFYING THE LOCATION OF THE WATER RIGHT ONLY AND IS NOT INTENDED TO PROVIDE DIMENSION OR LOCATION OF PROPERTY OWNERSHIP LINES.