

NOTES

THIS MAP DOES NOT CONSTITUTE A BOUNDARY SURVEY.

THE PURPOSE OF THIS MAP IS TO SHOW THE POINT OF DIVERSION, WATER SYSTEM, AND HOUSE FOR APPLICATION # S- , PERMIT # S-

1" BLACK POLLY WATER PIPE
LENGTH = 1180'

460' N + 45' E from Corner of Sec 27
and Sec 34, Located in the SW 1/4 of
The SE 1/4 of Sec 27

TIN R10W.M.

GOL. TAX Lot 4
(300)

POD WITH FISH SCREEN
N 460'
E 45'


Reference
Point

Section
27

Section
34

Point of Use
TIN R10W 34B
NE 1/4 of NW 1/4

TAX Lot 400

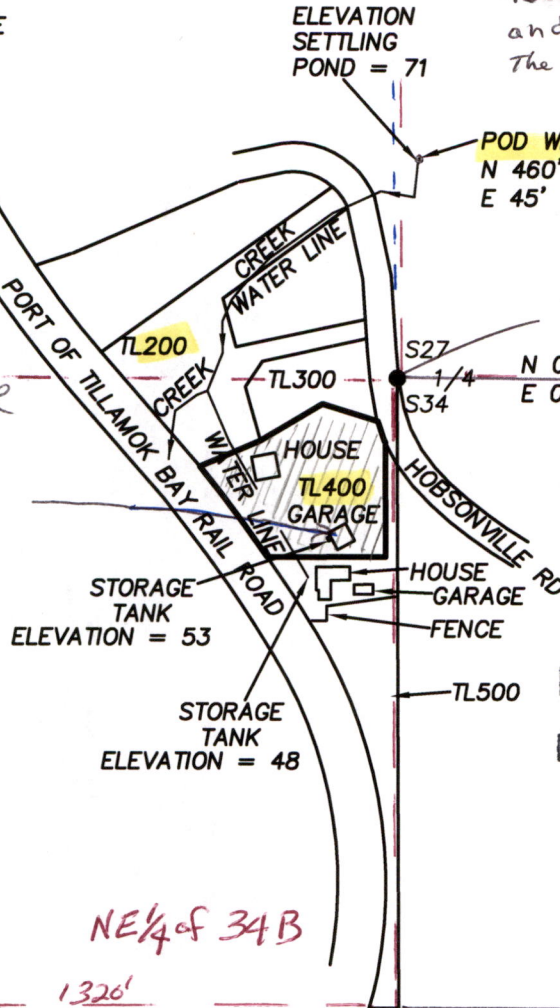

RECEIVED
FEB 02 2024
OWRD

RECEIVED
SEP 29 2023
OWRD
SALEM, OREGON



RENEWAL DATE JUNE 30, 2025

SURVEY BY:

TERRY JONES

11765 HWY 101 SOUTH
TILLAMOOK, OR. 97141
(503) 842-5551

WATER RIGHTS MAP FOR:

JEFFREY SLUYTER

TAX LOT 400
NW 1/4 SECTION 34
T1N, R10W, W.M.

TILLAMOOK COUNTY, OREGON

Received by OWRD

FEB 20 2024

Salem, OR

DATE	EQUIPMENT: HIPER V	FIELD	DRAWN	CHECKED	JOB NO.
JULY 2023	TOPCON ES-103 FC-5000	TLJ/DWE	TLJ	TLJ	

SLUYTER-WR.DWG
HARPHALE.CR5