



T. 9 S., R. 40 E., W.M.

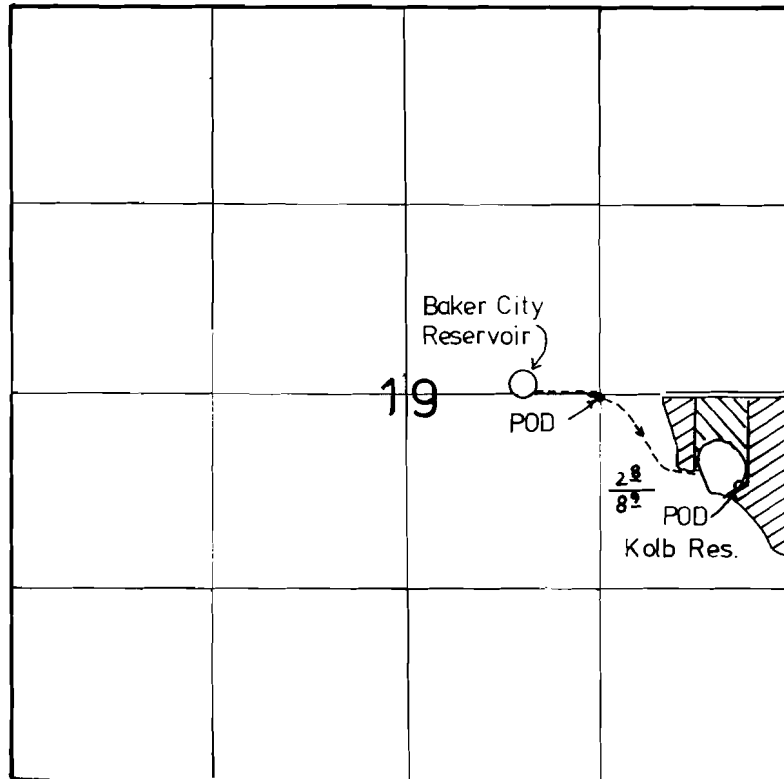

POD 1- 5' South & 1300' West

POD 2-620' South & 350' West

Both being from the E. 1/4 COR. SEC.19

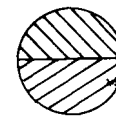

PRIMARY ACRES
Supplemental Acres

FINAL PROOF SURVEY

UNDER

Application No. R-61086 Permit No. R 8297
61087 45920

IN NAME OF

ROBERT P. ELLINGSON III

Surveyed 8-6, 1990, by K. KEMP