

T.2S., R.4E., W.M.

SECTION 1

36 | 31

1 | 6

1/4 CORNER


1/16 CORNER

THE DAM BEARS S3°46'05"W,
1242 FEET FROM THE EAST
1/16 CORNER ON THE NORTH
LINE OF SECTION 1.

RECEIVED

AUG - 1 1996

WATER RESOURCES DEPT
SALEM OREGON

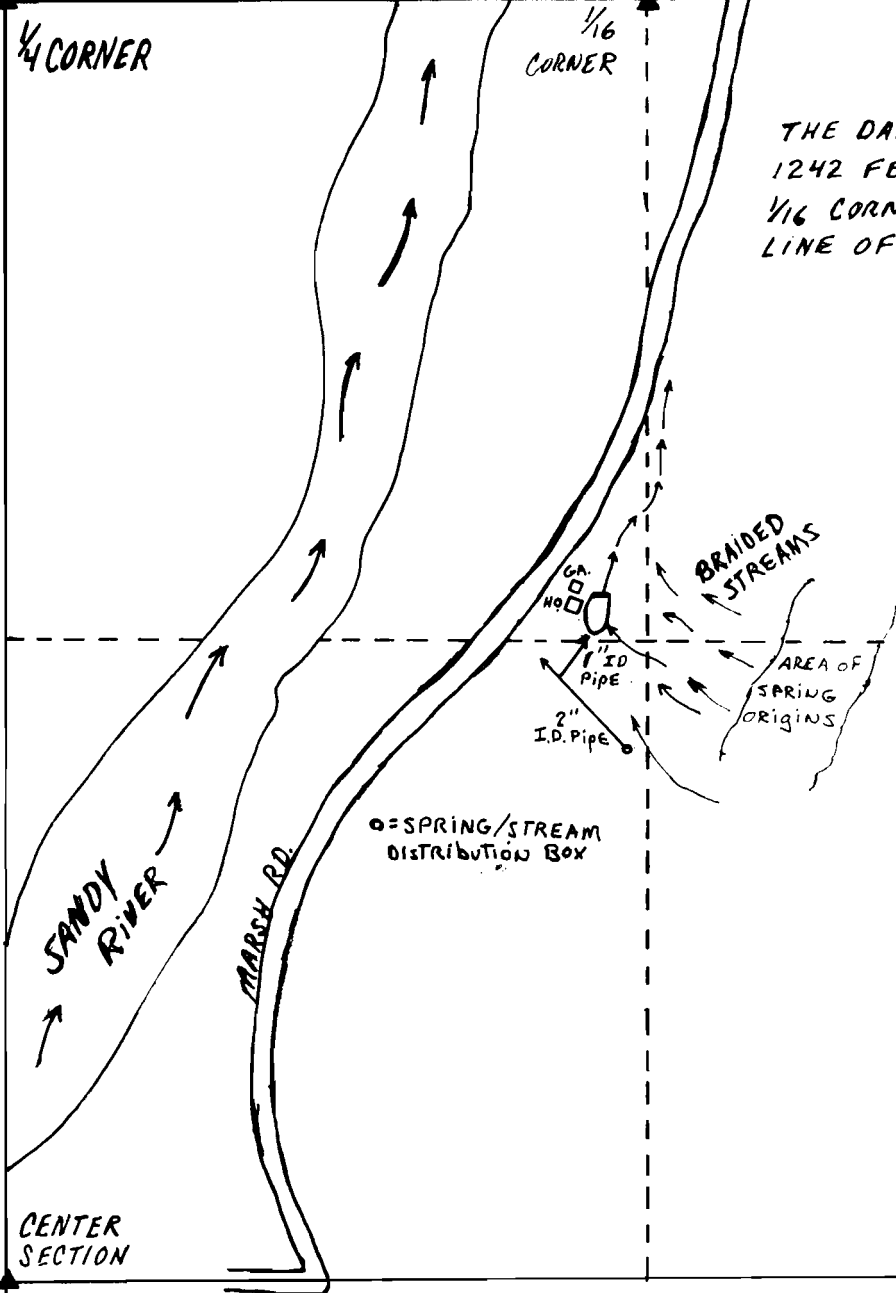

CENTER SECTION

1/4 CORNER

SCALE 1"=400'

BASIS OF BEARING P.S. # 11655

FINAL PROOF SURVEY

UNDER

APPLICATION # R-71954 PERMIT # R-11682
IN THE NAME OF

JAMES R. SNYDER III AND HELENA L. SNYDER

SURVEYED JULY 17, 1996 By PATRICK J. HINDS

