

CLAIM OF BENEFICIAL USE

APPLICATION No. R-71959

PERMIT No. R-11874



Tax Lot No. 10 38 1000 - Baker County

Deer Creek a tributary of Powder River

For: Donna C. Case
2505 5th Street
Baker City, OR 97814

T10S R38E

1/4

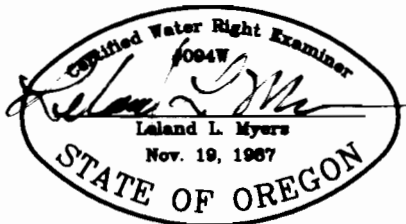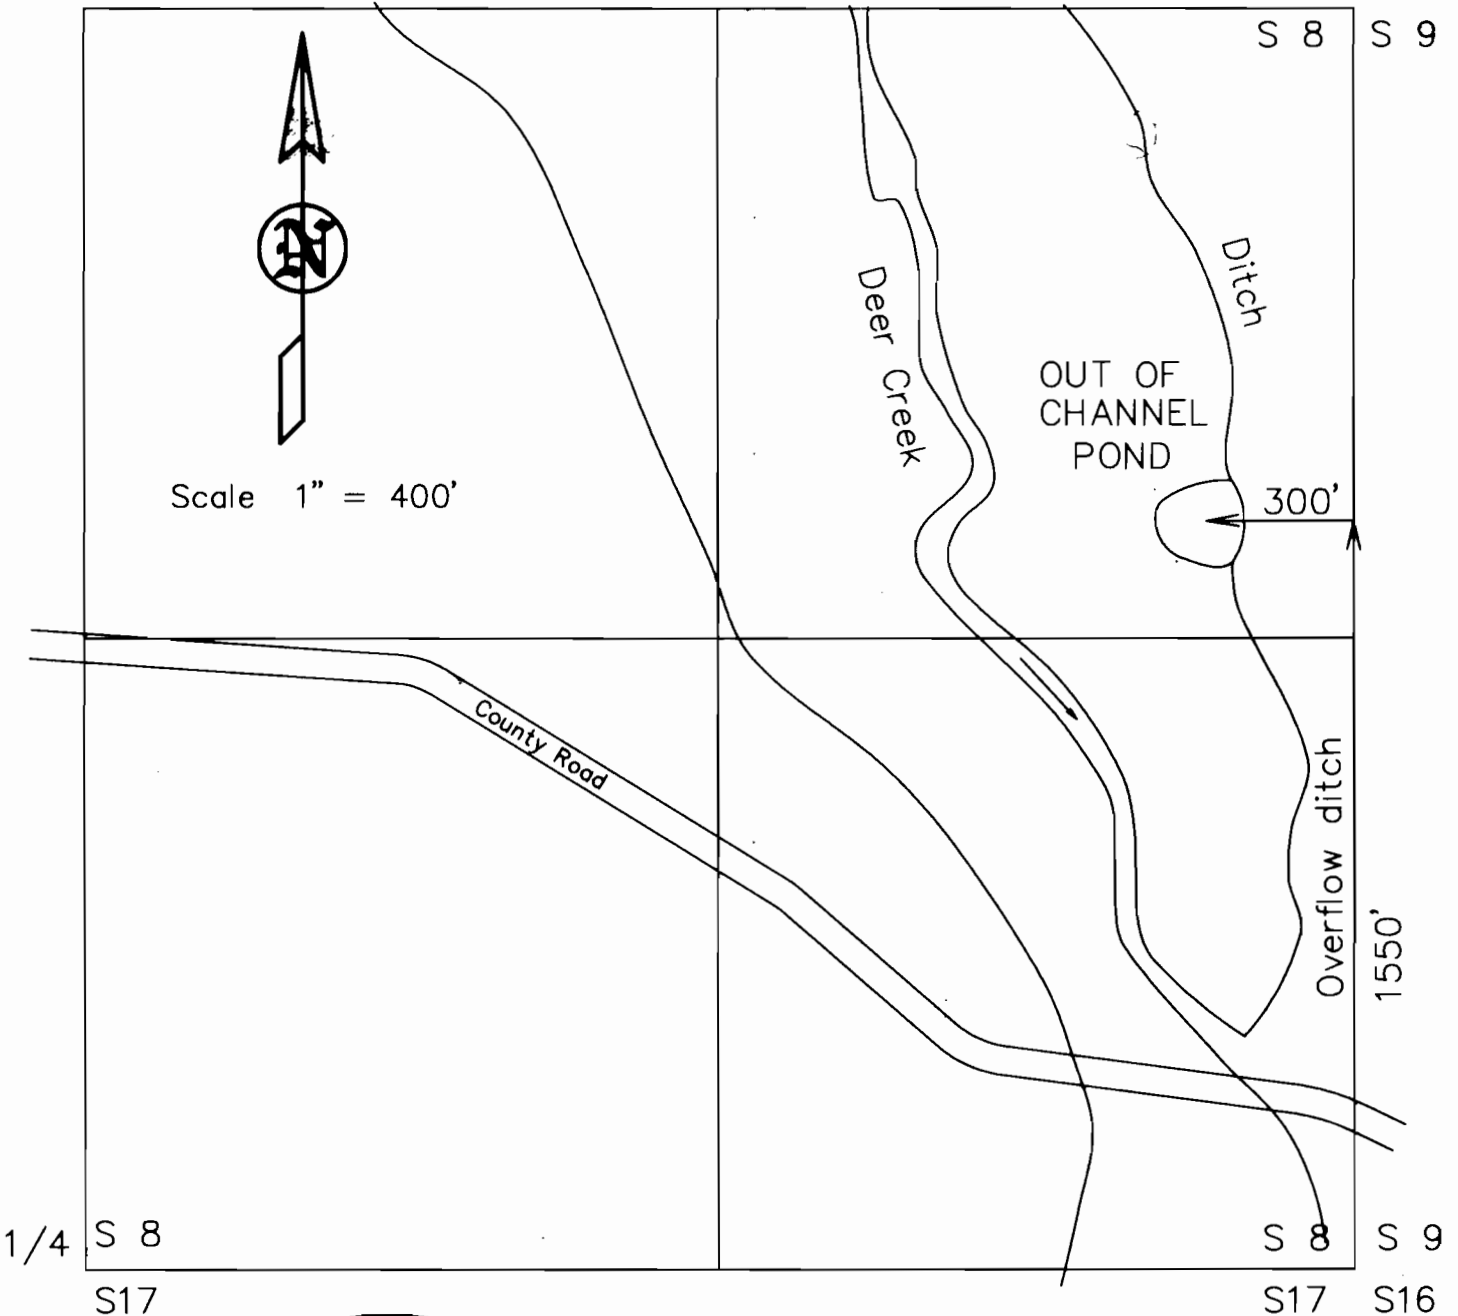

This map is for the purpose of identifying the location of the water right only and has no intent to provide dimensions or location of property ownership lines.

RECEIVED

SEP 8 9 2000

WATER RESOURCES DEPT.
SALEM, OREGON