


# Jane Stockfleth LLC Groundwater Application

G-18961 - AMENDED - April 2023

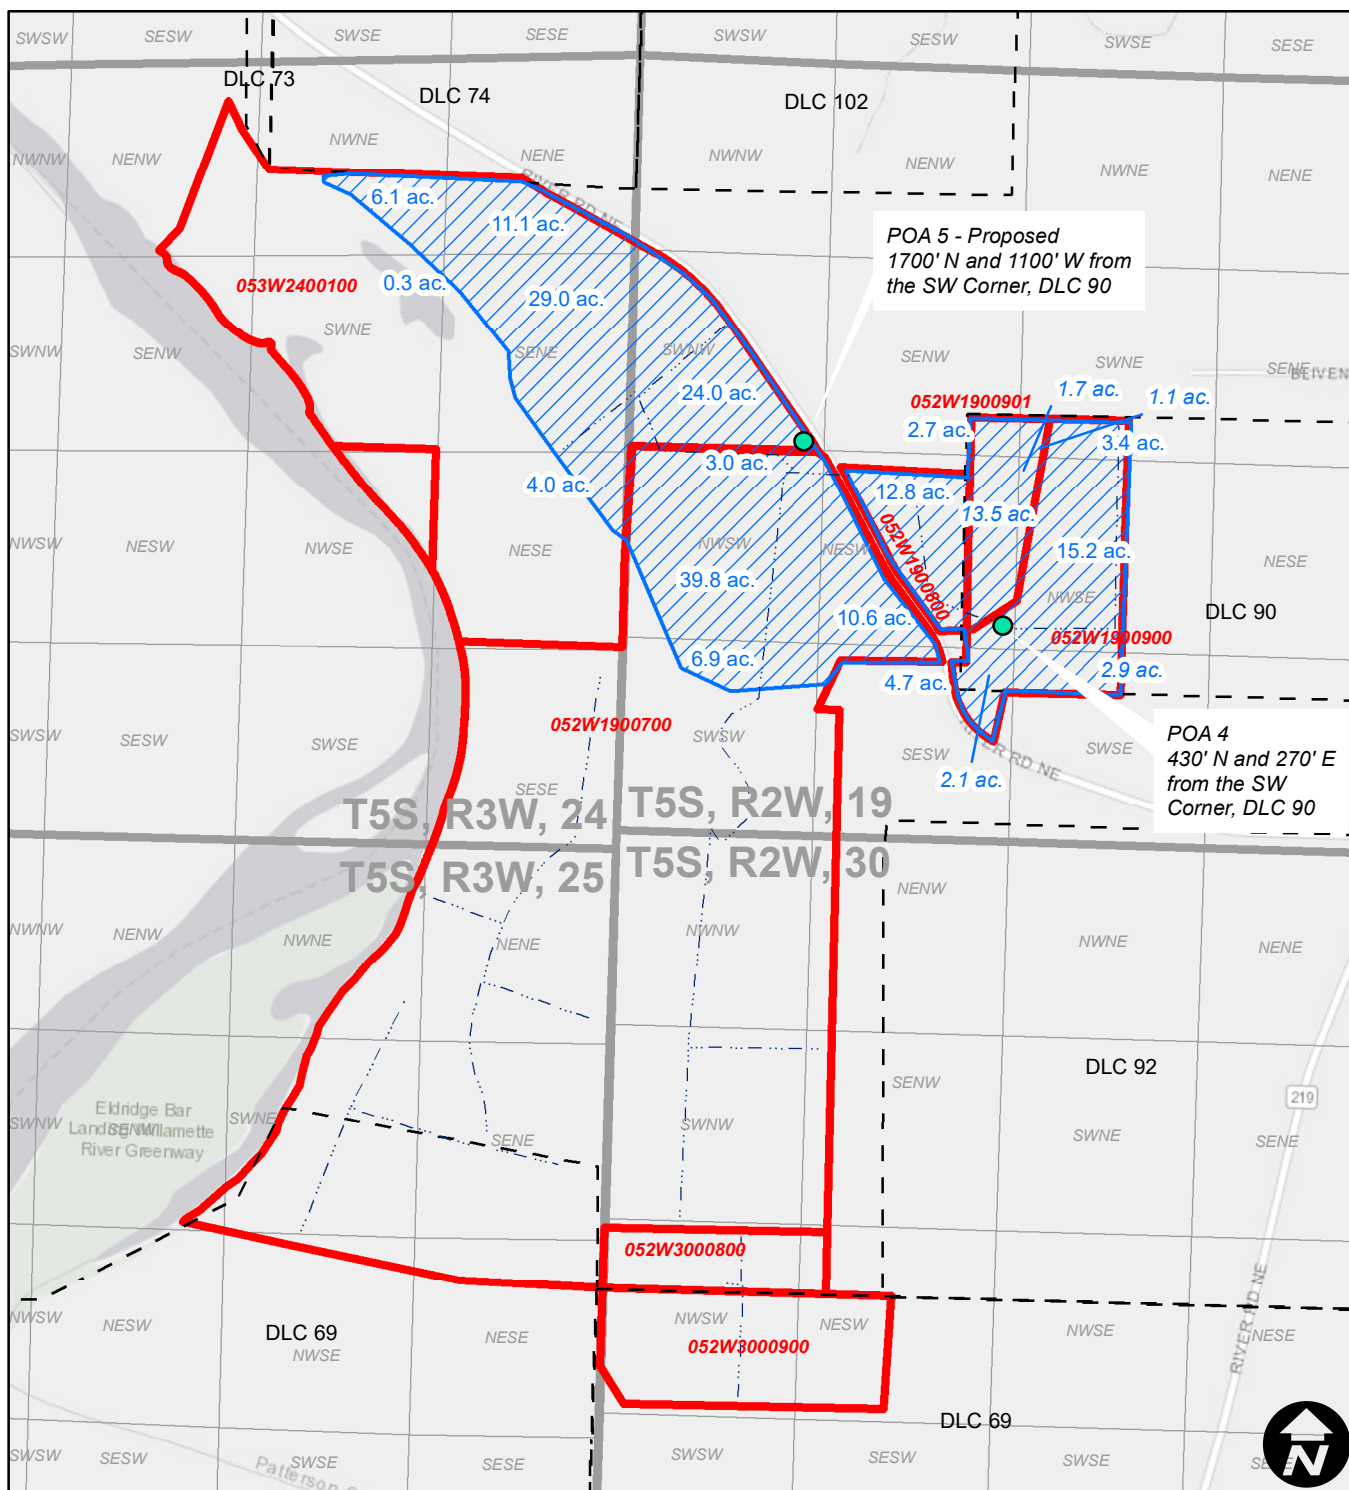

## Legend

- Proposed POU (194.9 ac.)
- Taxlot
- Mainline
- DLC

0 1,320 2,640 5,280 Feet

E-RECEIVED  
APR 20, 2023  
OWRD