

RECEIVED

MAY 13 1999



WATER RESOURCES DEP  
SALEM, OREGON

APPLICATION MAP

IN THE NAME OF SCOTT H. MC KENZIE

SECTIONS 29 & 32, T 31 S, R 15 W, W.M.

Brian and Kyle Arriola are assigning interest in their portion of Permit G-13029 (as amended by T-8138), being 25.0 ac of supplemental cranberry operations in the NWNW of Section 31, to McKenzie Family Properties, LLC and AgWest Farm Credit

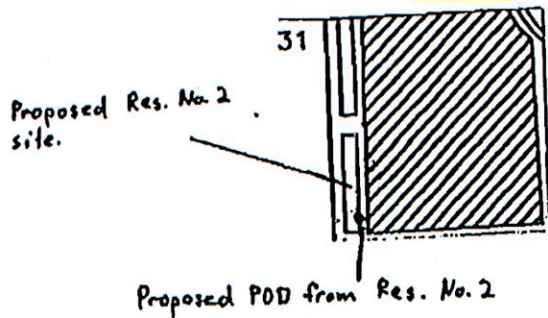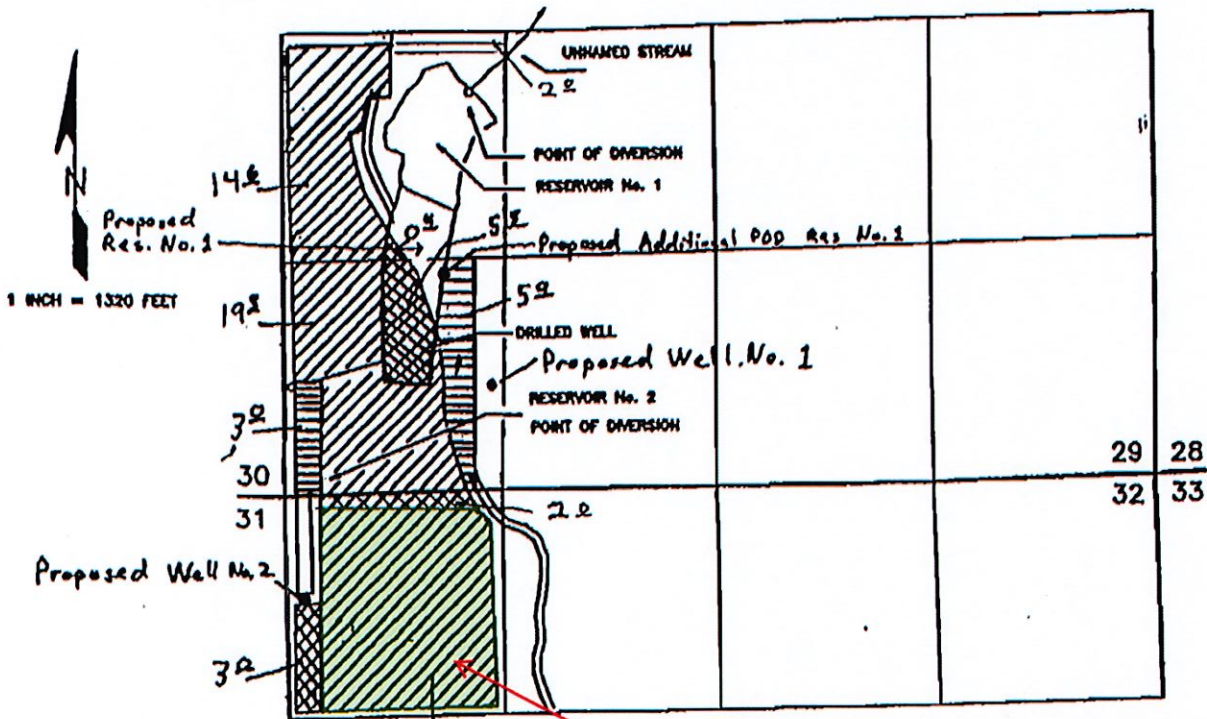

Portion of permit being assigned

"From" POV



Proposed "To" POV



Received

FEB 12 2024

OWRD