

RECEIVED

T29S R3W WM

SEP 15 1999

WATER RESOURCES DEPT
SALEM, OREGON

DANIEL T. CRAIG
DLC 37

FOUND
BRASS CAP
AT 1/4
CORNER
19/20

HOUSE 

NW 1/4
SW 1/4

SECTION 19
SECTION 20

N 32°54' W
968
DITCH
RES.
UNNAMED

STREAM


DITCH

LANE

SOUTH

MYRTLE

ROAD

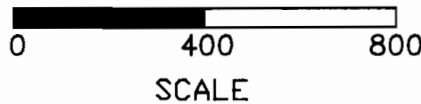

SCALE

SOUTH
MYRTLE
CREEK

THIS MAP TO BE USED
FOR WATER RIGHT
PURPOSES ONLY.

APPLICATION # R-72050 PERMIT # R-11949
MAP FOR CLAIM OF BENEFICIAL USE
IN NAME OF *Richard M. Deam*

DATE SEPT. 7, 1999

BY: WILLIAM J. RUPPERT
P.O. BOX 1564
MYRTLE CREEK, OR 97457

