

MAR 11 2024

Salem, OR



**Oregon Water Resources Department**  
 725 Summer Street NE, Suite A  
 Salem, Oregon 97301  
 (503) 986-0900  
 www.oregon.gov/OWRD

## Ownership Update for Certificated Rights Only

### NO FEES ARE REQUIRED TO SUBMIT THIS FORM

**NOTICE:** A certificate of water right typically stays with the land. To track water right ownership, the Department requests that this form be submitted to the Department. **To update multiple rights, a separate form is required for each right.** If you have any questions about this form, please contact your local watermaster, or call the Water Resources Department at (503) 986-0900.

Note: Use the assignment form to change ownership on pending applications, permits, transfers, groundwater registrations, or limited licenses.

Current Landowner Information				
Name:	5404 Buyserie Road LLC			
Mailing Address:	5404 Buyserie Rd NE			
City:	St Paul	State:	OR	Zip: 97137
Phone:	503 633 8266	Email:	buyserie@yahoo.com	

Property Information				
County:	Marion	Township:	4	Range: 2w Section: 16
Tax Lot #:	00400			
Street Address of Water Right:	5404 Buyserie Rd NE St Paul OR 97137			

**Water Right Information**

Application:	S-47861
Permit:	S-35330
Certificate:	50723

Are all the lands associated with this water right owned by the requestor?  Yes  No


(If no, include a map showing the portion of the water right involved)

Signature and Date		
Name of individual completing form:	Douglas Buyserie	
Phone or email:	503 633 8266	Date: 11 March 2024
Signature of requestor:	Douglas Buyserie	

The Department does not change names on water right certificates. This form will be placed in the file for future reference only. If mailed, the Department will not provide acknowledgment of receipt.

This form can be mailed to the address above or sent by email to [wrd\\_dl\\_customerservice@water.oregon.gov](mailto:wrd_dl_customerservice@water.oregon.gov)

# T. 4 S., R. 2 W., W.M.

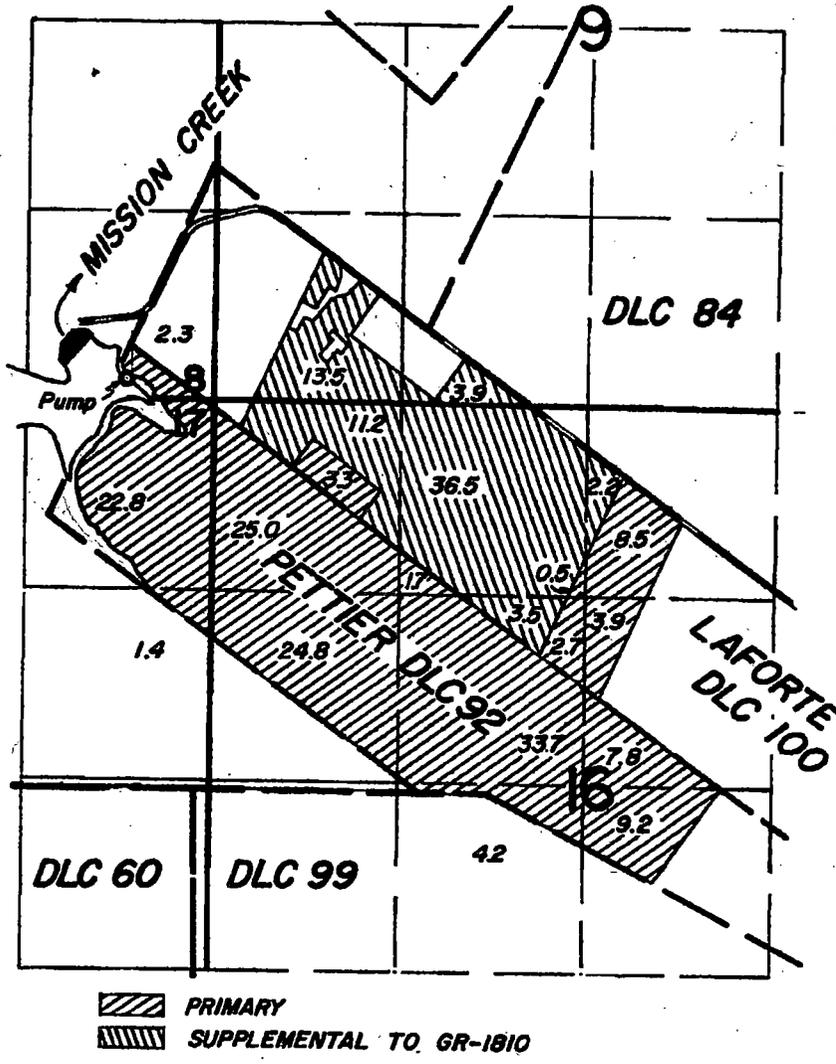

## FINAL PROOF SURVEY UNDER

Received by OWRD

MAR 11 2024

Salem, OR

R-47860 R-5667  
Application No. 47861 Permit No. 35330  
IN NAME OF

**DONALD & CLARA BUYSERIE**

Received by OWRD

MAR 1 X 2024

Salem, OR

Surveyed AUG. 17, 1977, by B. SUND