


T. 4 S. R. 4 W. W. M.

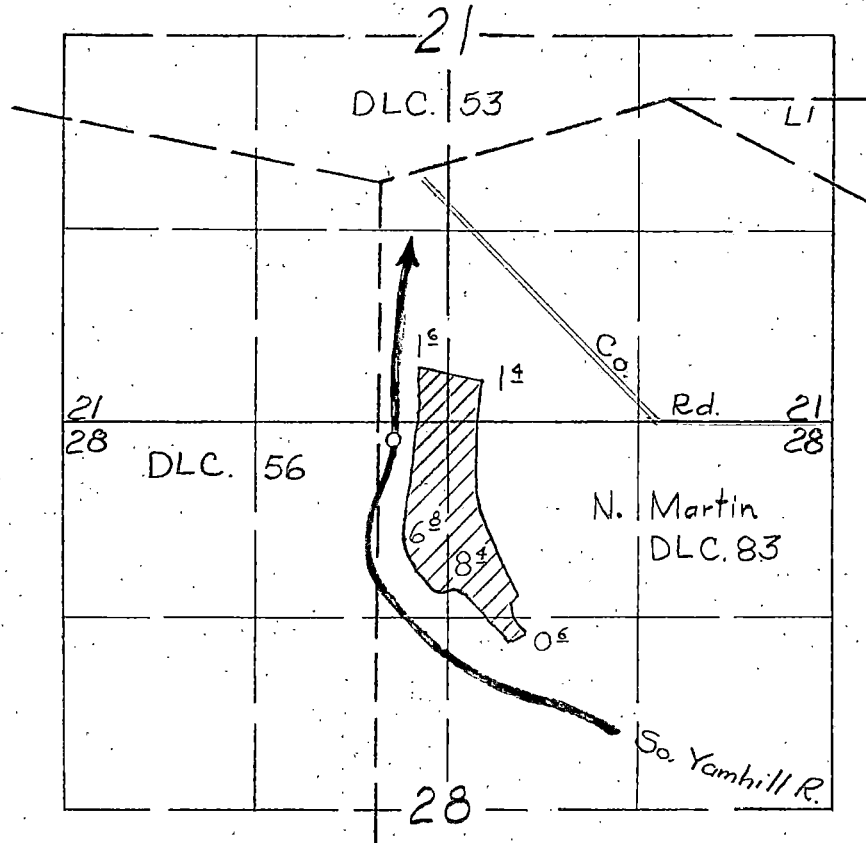

FINAL PROOF SURVEY  
UNDER

Application No. 17700 Permit No. 13386  
IN NAME OF

C.C. Meisel

Surveyed 13 June, 1956 by R.D. Best

DFQ-5D-64

BW-5