

RECEIVED

T. 5S., R. 39E., W. M.


1997




SCALE 1" = 1320'

The purpose of this map is for identifying the location of the water right only and is not intended to provide legal dimensions of property ownership lines.

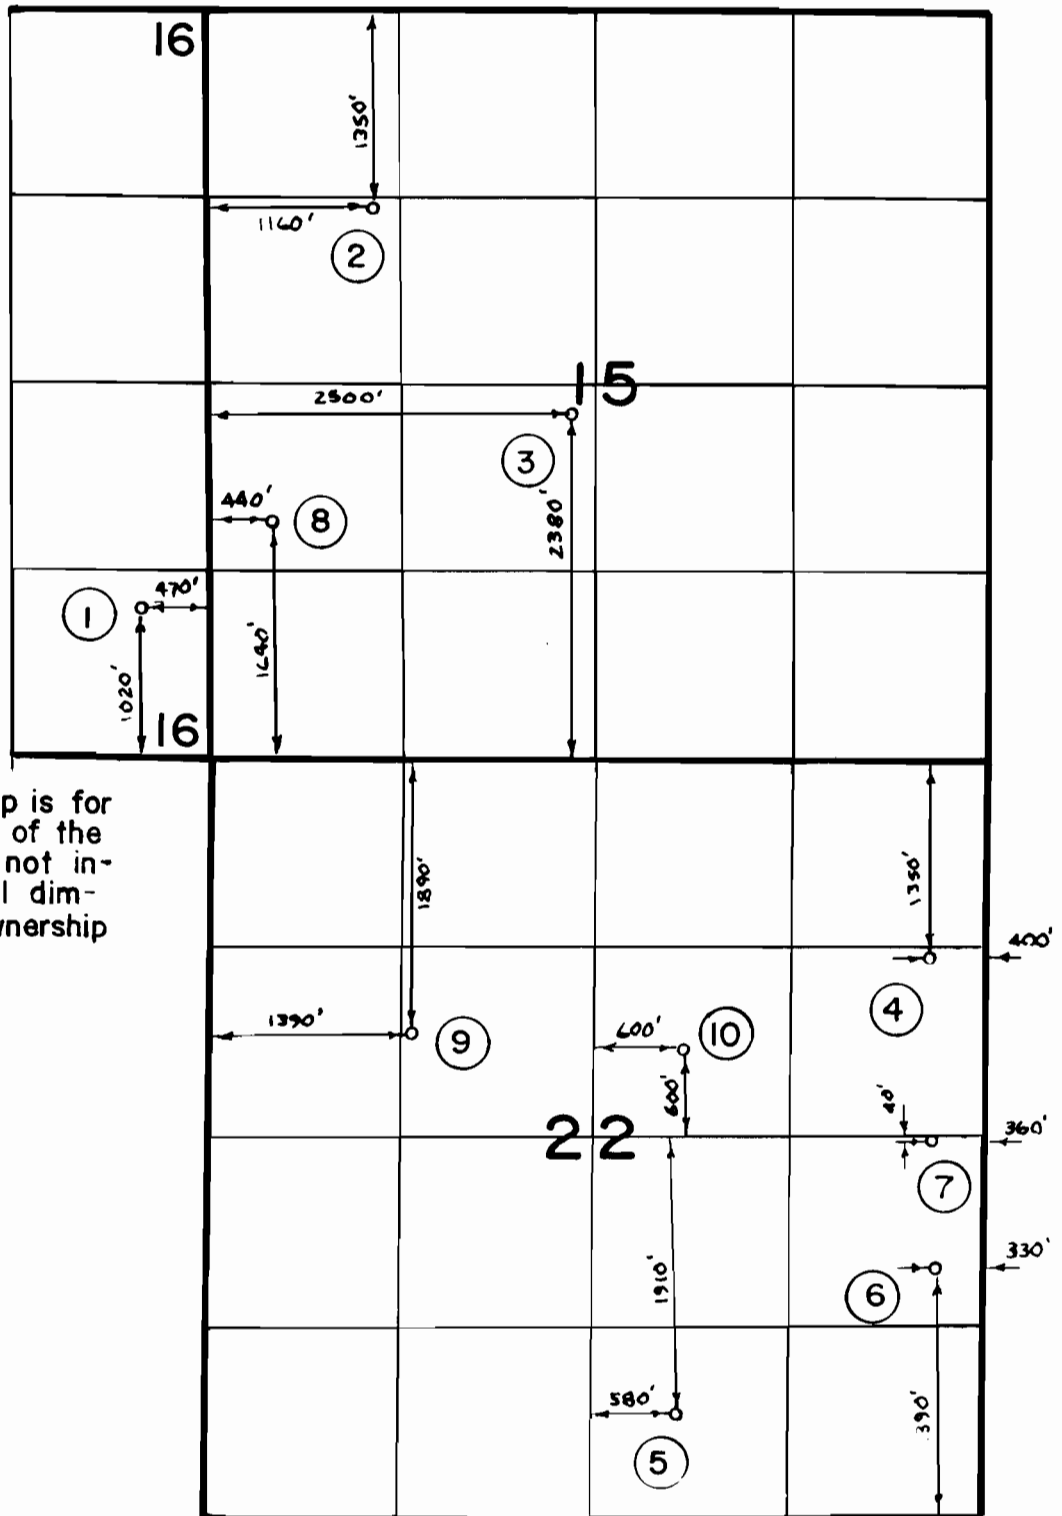

FINAL PROOF SURVEY UNDER

APPL. R-72053
72052

PER. R-11892
52205

IN NAME OF

WILSON CATTLE CO. INC.

