

**LEGEND**

- RANGE LINE
- SECTION LINE
- 1/4 1/4 LINE
- GOVERNMENT LOT LINE
- TAX LOT LINE
- CANAL/CREEK
- ROAD
- FLOW DIRECTION
- SECTION CORNER
- TAX LOT NUMBER
- GOVERNMENT LOT NUMBER
- POA (WELL)
- PRIMARY AND SUPPLEMENTAL IRRIGATION LANDS UNDER TRANSFER T-13501
- AUTHORIZED ACRES
- 1/4 1/4 SECTION
- AUTHORIZED ACRES GOVERNMENT LOT



**NOTES:**

1. THIS MAP WAS PREPARED FROM FIELD MEASUREMENTS, NAIP 2024 AERIAL PHOTOGRAPH, KLAMATH COUNTY TAX MAPS, AND OREGON GLO MAPS.
2. THE PURPOSE OF THIS MAP IS TO IDENTIFY THE LOCATION OF THE WATER RIGHT ONLY, AND IS NOT INTENDED TO PROVIDE DIMENSIONS OR LOCATION OF PROPERTY LINES.
3. THIS TRANSFER CHANGED THE POINT OF APPROPRIATION FOR TWO LAYERED WATER RIGHTS: CERTIFICATE 31787 (PRIMARY IRRIGATION) AND CERTIFICATE 37578 (SUPPLEMENTAL IRRIGATION).
4. DATE OF PRIORITY FOR CERTIFICATE 31787 WAS MAY 9, 1957.
5. DATE OF PRIORITY FOR CERTIFICATE 37578 WAS MARCH 17, 1965.

**WELL LOCATION:**

WELL 1 (KLAM 61330): 1820' SOUTH & 1150' WEST OF NE CORNER OF SECTION 24.

Received by OWRD  
MAR 13 2024

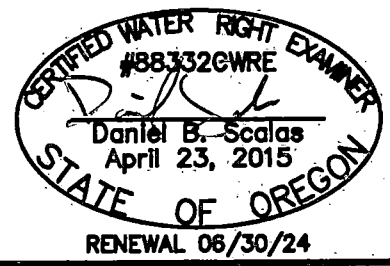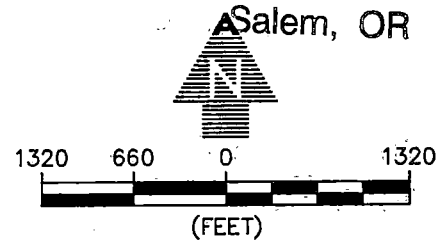

**ALADKINS** ENGINEERING & SURVEYING  
 o / 541.884.4666 w / AdkinsEngineering.com  
 1435 ESPLANADE AVENUE, KLAMATH FALLS, OR 97601  
 SERVING S. OREGON & N. CALIFORNIA

**CLAIM OF BENEFICIAL USE MAP**  
 FOR  
 GUTHRIE FARMS LLC  
 T40S, R9E, SEC. 24, WM  
 T40S, R10E, SECS. 18 & 19, WM  
 KLAMATH COUNTY  
 TRANSFER T-13501