

Well Location:
CROO 53900/ L-103113: 125' S, 60' E of NW Cor Sec 19



**T15S R15E &
T15S R16E, WM,
CROOK COUNTY, OR**



0 1,320 Feet

1" = 1320'


RECEIVED

FEB 26 2024

Received
OWRD

FEB 12 2024

OWRD

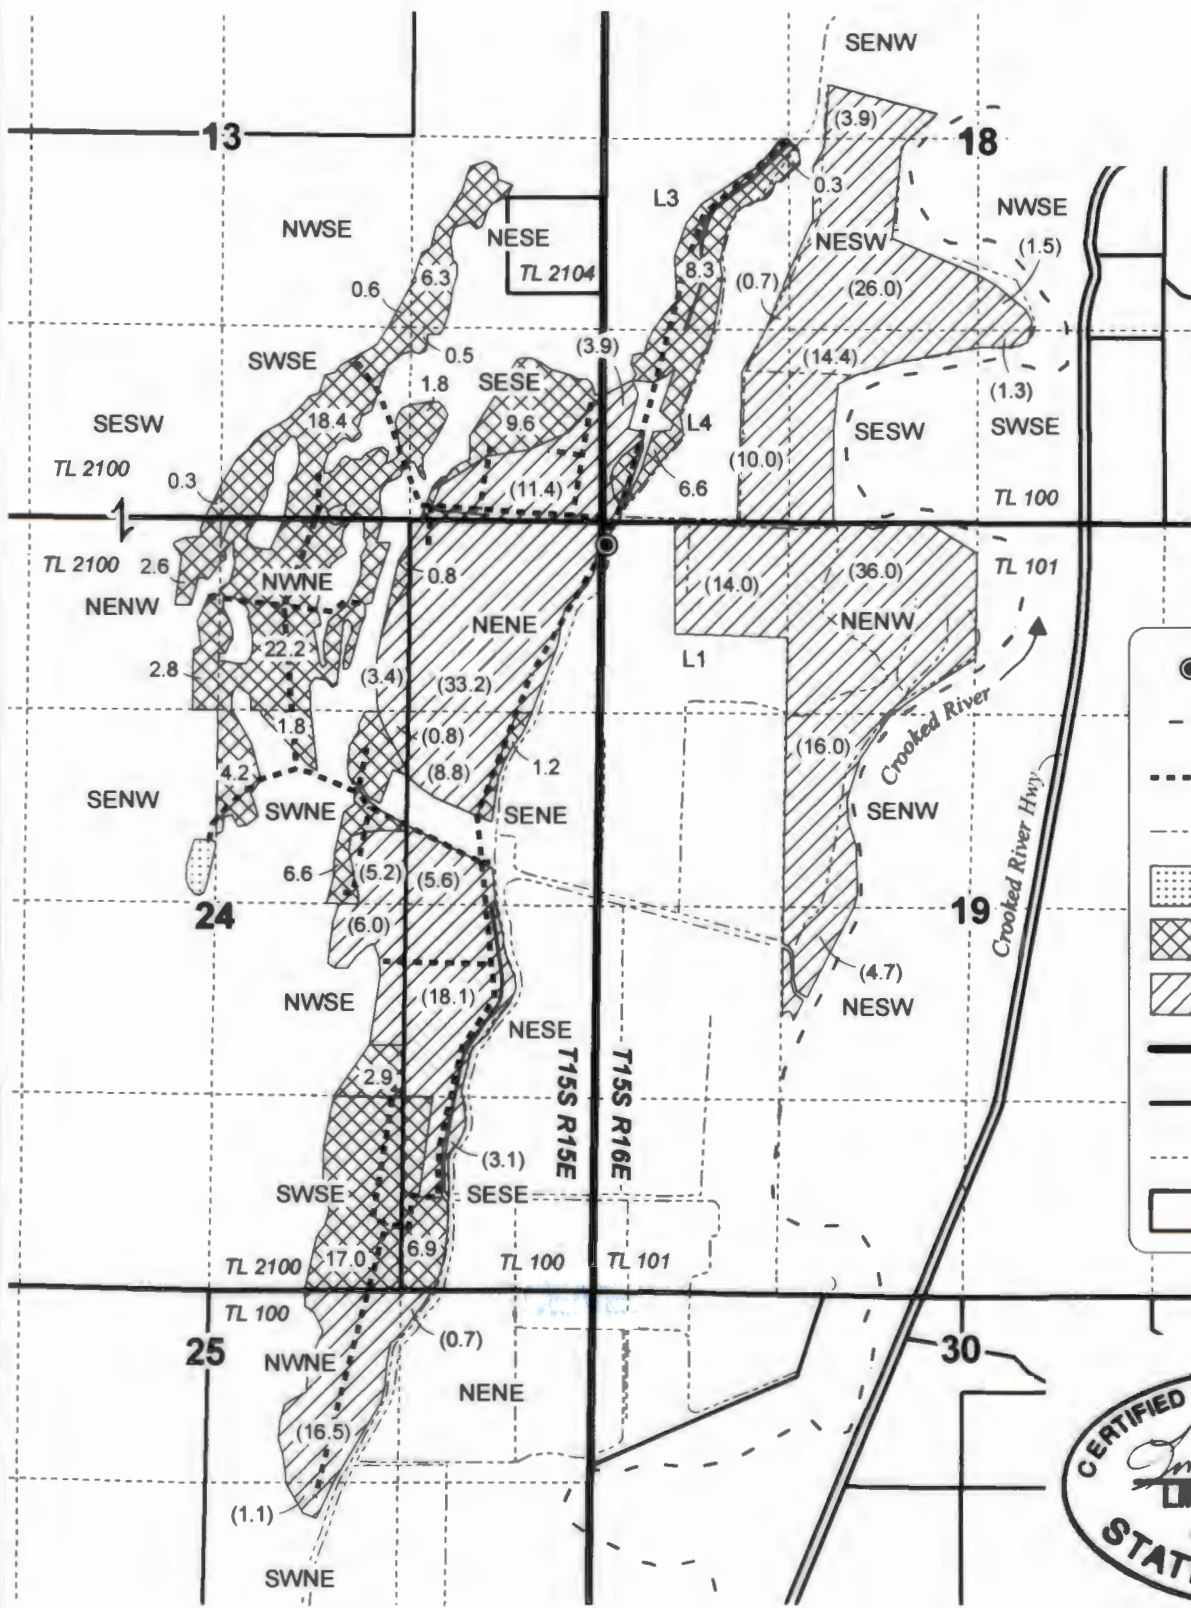

- ⊙ Well & Meter
- - - River
- - - Pipeline
- - - Ditch
- [Cross-hatched] Bulge-in-System
- [Diagonal lines] POU IR
- [Horizontal lines] POU (IS)
- Township
- Section
- - - Quarter Quarter
- [Box] Tax Lot



RENEWAL DATE 12/31/2024

**CLAIM OF BENEFICIAL USE MAP
WHITE DEER RANCH #22073**

Date: 1/17/2024 Ap G-14150 / T-11889 Permit G-18889

This map is not intended to provide legal dimensions or locations of property ownership lines.

WATER RIGHT SERVICES, LLC
PO BOX 1830, BEND, OR 97709
WWW.OREGONWATER.US CCB # 197121
johnshort@usa.com 541-389-2837